


STATE OF KANSAS
STATE CORPORATION COMMISSION

Form CP-4

Give All Information Completely
Make Required Affidavit
Mail or Deliver Report to:
Conservation Division
State Corporation Commission
212 No. Market
Wichita, Kansas

WELL PLUGGING RECORD

NORTH

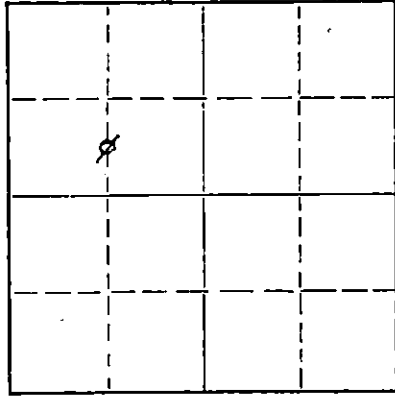

Locate well correctly on above Section Plat

Seward County, Sec. 14 Twp. 34S Rge. 34W (E) (W)
Location as "NE/CNW&SWW" or footage from lines C S/2 NW/4
Lease Owner Publishers Petroleum
Lease Name Keating Well No. 1-14
Office Address Box 25125, Okla. City, Okla. 73125
Character of Well (completed as Oil, Gas or Dry Hole) D&A
Date well completed 9-22-69 19
Application for plugging filed 9-22-69 19
Application for plugging approved 9-26-69 19
Plugging commenced 9-22-69 19
Plugging completed 9-22-69 19
Reason for abandonment of well or producing formation Non-commercial

If a producing well is abandoned, date of last production - 19
Was permission obtained from the Conservation Division or its agents before plugging was commenced? Yes

Name of Conservation Agent who supervised plugging of this well Mr. Eves, Sublette, Kansas
Producing formation _____ Depth to top _____ Bottom _____ Total Depth of Well 6650 Feet
Show depth and thickness of all water, oil and gas formations.

OIL, GAS OR WATER RECORDS

CASING RECORD

FORMATION	CONTENT	FROM	TO	SIZE	PUT IN	PULLED OUT
Sand, Anhydrite	Water	0	1690	8-5/8"	1689	0
Toronto	Water	4336	4400			
Lansing	Water	4452	4790			
Marmaton	Water	5132	5420			
Morrow	Dry	6026	6080			
Chester	Dry	6373	6400			
St. Louis	Water	6470	6650			

Describe in detail the manner in which the well was plugged, indicating where the mud fluid was placed and the method or methods used in introducing it into the hole. If cement or other plugs were used, state the character of same and depth placed, from _____ feet to _____ feet for each plug set.

Hole filled with mud.
35 sacks cement plug pumped from 800' to 900'.
15 sacks cement plug pumped from surface to 50'.

RECEIVED
STATE CORPORATION COMMISSION
OCT 6 1969
CONSERVATION DIVISION
Wichita, Kansas


(If additional description is necessary, use BACK of this sheet)

Name of Plugging Contractor Dowell
Address Guymon, Oklahoma

STATE OF Oklahoma, COUNTY OF Oklahoma, ss.
W. C. Ireland (employee of owner) or (owner) of the above-described well, being first duly sworn on oath, says: That I have knowledge of the facts, statements, and matters herein contained and the log of the above-described well as filed and that the same are true and correct. So help me God.

(Signature) *W. C. Ireland*
(Address)

Subscribed and sworn to before me this 29th day of September, 1969.
Veva J. Cornelson
Veva J. Cornelson Notary Public.

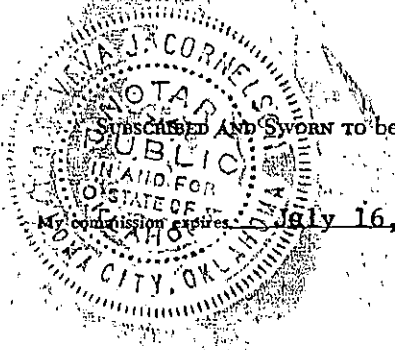



DEPARTMENT OF MINES AND MINERALS
OIL AND GAS DIVISION

STATE OF KANSAS

EXCISE TAX
Restored, 1967

Permit No.

Oil or Gas Well Dry Hole
(Kind)

Company PUBLISHERS PETROLEUM COMPANY
Address Box 25125, Oklahoma City, Oklahoma

Casing and Used in Left In Tubing
Drilling Well

Farm KEATING Acres

Size

Location (waters) Section 14-34S-34W

Kind of Packer

Well No. 1-14 Elev.

Size of

District

Ran 1692' 8-5/8" set @ 1689' w/500 Skts

Drilling Commenced September 6, 1969

Depth Set Cement

Drilling Completed September 22, 1969

Perf. top

Name of Contractor LOHMANN-JOHNSON DRILLING CO., INC

Perf. bottom

Address of Contractor 320 Indiana Bank Bldg., Evansville, Indiana 47708

Date Shot From

Perf. top

With

Perf. bottom

Open flow /10ths Water in

Casing Cemented

/10ths Merc. in

Formation	Color	Hard or Soft	Top	Bottom	Oil, Gas & Coal or Water	Depth Found	Remarks
SAND & RED BED			0	925			
RED BED			925	1053			
SAND			1053	1643			
SHALE & SHELLS			1643	1684			
ANHYDRITE			1684	1790			
RED BED			1790	2410			
LIME & SHALE			2410	2645			
LIME			2645	3900			
LIME & SHALE			3900	4067			
SHALE & LIME			4067	4170			
LIME			4170	4314			
LIME & SHALE			4314	4570			
LIME			4570	5570			
SHALE			5570	6072			
SHALE & LIME			6072	6348	Dry & Abandoned		
LIME			6348	6650	Plugged 9/22/69		
TOTAL DEPTH			6650				

RECEIVED
STATE CORPORATION COMMISSION
OCT 6 1969
CONSERVATION DIVISION
Wichita, Kansas

We, the undersigned, LOHMANN-JOHNSON DRILLING CO., INC., hereby certifies that the above is a true and correct Log of the formations encountered in drilling this Well in accordance with the Daily Drilling Reports.

LOHMANN-JOHNSON DRILLING CO., INC

By J.B. Lohmann
J.B. Lohmann, President

Subscribed and sworn to before me this 1st day of October, 1969

Helis V. Fields
Notary Public

My Commission expires November 5, 1969

