

STATE OF KANSAS  
STATE CORPORATION COMMISSION

Form CP-4

Give All Information Completely  
Make Required Affidavit  
Mail or Deliver Report to:  
Conservation Division  
State Corporation Commission  
212 No. Market  
Wichita, Kansas 67202

WELL PLUGGING RECORD

Seward County, Sec. 8 Twp. 34S Rge. 34 (X X W)

Location as "NE/CNW/SW" or footage from lines C NW SE

Lease Owner Petroleum, Inc.

Lease Name Heath Unit Well No. 1

Office Address 8th Fl., R. H. Garvey Bldg., Wichita, Kansas 67202

Character of Well (completed as Oil, Gas or Dry Hole) Dry Hole

Date well completed 11-24-73 19

Application for plugging filed 11-24-73 19

Application for plugging approved 11-24-73 19


Plugging commenced 11-24-73 19

Plugging completed 11-24-73 19

Reason for abandonment of well or producing formation commercial quantities of oil not found

If a producing well is abandoned, date of last production 19

Was permission obtained from the Conservation Division or its agents before plugging was commenced? yes

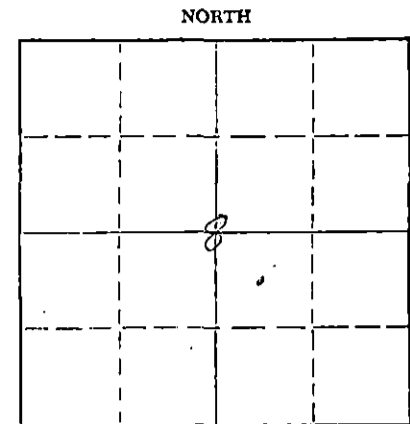

Locate well correctly on above Section Plat

Name of Conservation Agent who supervised plugging of this well Edgar Eves - Sublette, Kansas

Producing formation Depth to top Bottom Total Depth of Well 6650 Feet

Show depth and thickness of all water, oil and gas formations.

OIL, GAS OR WATER RECORDS

CASING RECORD

FORMATION	CONTENT	FROM	TO	SIZE	PUT IN	PULLED OUT
				8 5/8"	1618'	None

Describe in detail the manner in which the well was plugged, indicating where the mud fluid was placed and the method or methods used in introducing it into the hole. If cement or other plugs were used, state the character of same and depth placed, from feet to feet for each plug set.

Plug w/ 35 sx. at 1000-900'  
Plug w/ 15 sx. at 45 - 0.

RECEIVED  
STATE CORPORATION COMMISSION  
DEC 7 1973  
CONSERVATION DIVISION  
Wichita, Kansas

(If additional description is necessary, use BACK of this sheet)  
Name of Plugging Contractor Rains & Williamson Oil Co., Inc.  
Address 435 Page Court, 220 W. Douglas, Wichita, Kansas 67202

STATE OF KANSAS, COUNTY OF SEDGWICK, ss.  
Wilson Rains, President of Rains & Williamson Oil Co., Inc. (employee of owner) or (owner or operator) of the above-described well, being first duly sworn on oath, says: That I have knowledge of the facts, statements, and matters herein contained and the log of the above-described well as filed and that the same are true and correct. So help me God.

(Signature) Wilson Rains  
435 Page Court, 220 W. Douglas, Wichita, Kansas 67202 (Address)

Subscribed and sworn to before me this 27th day of November, 1973


My commission expires October 4, 1975  
Juanita M. Green Notary Public.



# WELL LOG

COMPANY Petroleum, Inc.  
 FARM Heath Unit NO. 1  
 RIG. NO. 6  
 TOTAL DEPTH 6650  
 COMM. 11-1-73 COMP. 11-24-73  
 CONTRACTOR Rains & Williamson Oil Co., Inc.

SEC. 8 T. 34S R. 34W  
 LOC. C NW SE

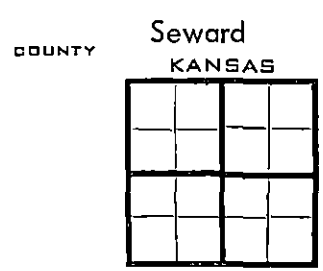

CASING  
 20 10  
 15 8 5/8" @ 1618' w/ 700 sx. Halco LW, 2% cc.,  
 12 6 & 200 sx. Class H., 3% cc.  
 13 5

ELEVATION  
 PRODUCTION D & A

FIGURES INDICATE BOTTOM OF FORMATIONS

Conductor	40
Sand and Clay	140
Clay, Sand and Red Bed	825
Sand and Red Bed	1122
Red Bed and Sand	1562
Red Bed, Sand & Anhydrite	1618
Shale	1650
Anhydrite and Shale	2335
Lime and Shale	2420
Shale and Lime	2685
Lime and Shale	5775
Shale and Lime	5825
Shale and Sand	5860
Shale	5920
Lime and Shale	6650
<u>Rotary Total Depth</u>	<u>6650</u>

RECEIVED  
 STATE CORPORATION COMMISSION  
 DEC 7 1973  
 CONSERVATION DIVISION  
 Wichita, Kansas

State of KANSAS  
 County of SEDGWICK ss:

I, Wilson Rains, President of the Rains & Williamson Oil Co., Inc.  
 upon oath state that the above and foregoing is a true and correct copy of the log of the Heath Unit #1 well.

Wilson Rains  
 WILSON RAINS



Subscribed and sworn to before me this 27th day of November 19 73

My Commission Expires: October 4, 1975

Juanita M. Green  
 NOTARY PUBLIC  
 Juanita M. Green