


WELL PLUGGING RECORD

Give information Completely
Make Affidavit
Mail Report to:
Conservation Division
State Corporation Commission
212 No. Market
Wichita, Kansas

Seward County, Sec. 4 Twp. 34S Rge. (E) 34 (W)

Location as "NE/CNW'SW" or footage from lines C SW NE
Lease Owner Wilmar Oil, Inc.
Lease Name McGill Nicks Well No. 1
Office Address P. O. Box 474, Mattoon, Illinois
Character of Well (completed as Oil, Gas or Dry Hole) Gas
Date well completed February 15, 1969 1969
Application for plugging filed October 8, 1973 1973
Application for plugging approved October 8 1973
Plugging commenced October 11 1973
Plugging completed October 20 1973
Reason for abandonment of well or producing formation Depleted

If a producing well is abandoned, date of last production May 12, 1971
Was permission obtained from the Conservation Division or its agents before plugging was commenced? Yes

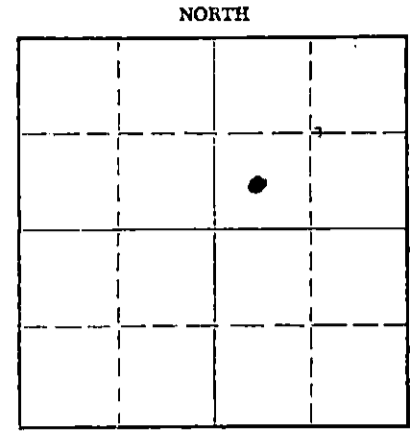

Locate well correctly on above Section Plat

Name of Conservation Agent who supervised plugging of this well
Producing formation U. Morrow Depth to top 5772 Bottom 5786 Total Depth of Well 6550 Feet
Show depth and thickness of all water, oil and gas formations.

OIL, GAS OR WATER RECORDS

CASING RECORD

| FORMATION | CONTENT | FROM | TO | SIZE | PUT IN | PULLED OUT |
|-----------|---------|------|------|--------|--------|------------|
| U. Morrow | 623 | 5772 | 5786 | 8-5/8" | 1696' | None |
| | | | | 5-1/2" | 6530' | 1876.51' |
| | | | | | | |
| | | | | | | |
| | | | | | | |
| | | | | | | |

Describe in detail the manner in which the well was plugged, indicating where the mud fluid was placed and the method or methods used in introducing it into the hole. If cement or other plugs were used, state the character of same and depth placed, from _____ feet to _____ feet for each plug set.

A 20 sack cement plug was pumped to 5621 feet. Pipe was shot free at 3723 feet. Pulled 1 joint. Pipe hung up - Pulled pipe in two at approximately 1870 feet. Pumped 35 sack cement plug from 1000 feet to 1105 feet. Finished pulling pipe. Capped well with 18 sacks cement. Cut off surface pipe and welded on steel plate.

RECEIVED
STATE CORPORATION COMMISSION
NOV 8 1973
CONSERVATION DIVISION
Wichita, Kansas

(If additional description is necessary, use BACK of this sheet)
Name of Plugging Contractor Clyde A. Reeves & Son, Inc.
Address P. O. Box 94204, Oklahoma City, Oklahoma 73109

STATE OF Oklahoma, COUNTY OF Oklahoma
Charles M. Thomas (employee of owner) or (owner or operator) of the above-described well, being first duly sworn on oath, says: That I have knowledge of the facts, statements, and matters herein contained and the log of the above-described well as filed and that the same are true and correct. So help me God.
(Signature)

SUBSCRIBED AND SWORN TO before me this 5th day of November, 1973
Elizabeth Baxter
(Address)
Notary Public.

My commission expires Sept. 5, 1977

