


STATE OF KANSAS
STATE CORPORATION COMMISSION

Form CP-4

WELL PLUGGING RECORD

Give All Information Completely
Make Required Affidavit
Mail or Deliver Report to:
Conservation Division
State Corporation Commission
211 No. Broadway
Wichita, Kansas

Seward County, Sec. 36 Twp. 34S Rge. 33W (E) (W)
Location as "NE/CNW/SW" or footage from lines 1980'

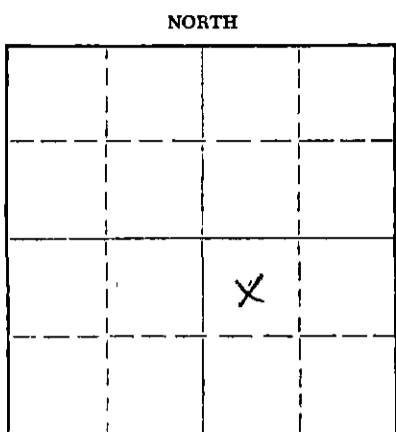

Lease Owner Wm. Gruenerwald & Assoc., Inc.
Lease Name Bassett- Light Well No. 1
Office Address 3 E. Wacker Drive, Chicago, Ill.
Character of Well (completed as Oil, Gas or Dry Hole) Dry Hole
Date well completed 9-23, 64 19
Application for plugging filed Permission granted 19
Application for plugging approved from Hugh Scott 19 64
Plugging commenced 9-23-64 19 64
Plugging completed Ditto 19
Reason for abandonment of well or producing formation Dry
If a producing well is abandoned, date of last production _____ 19
Was permission obtained from the Conservation Division or its agents before plugging was commenced? Yes

Name of Conservation Agent who supervised plugging of this well Hugh Scott
Producing formation _____ Depth to top _____ Bottom _____ Total Depth of Well 6280' Feet
Show depth and thickness of all water, oil and gas formations.

OIL, GAS OR WATER RECORDS

CASING RECORD

FORMATION	CONTENT	FROM	TO	SIZE	PUT IN	PULLED OUT

Describe in detail the manner in which the well was plugged, indicating where the mud fluid was placed and the method or methods used in introducing it into the hole. If cement or other plugs were used, state the character of same and depth placed, from _____ feet to _____ feet for each plug set. Cement

3 Sack plug @ 700' 10 Sack plug @ surface

RECEIVED
STATE CORPORATION COMMISSION
OCT 12 1964
CONSERVATION DIVISION
Wichita, Kansas

(If additional description is necessary, use BACK of this sheet)
Name of Plugging Contractor Graham-Michaelis Drilling Co.
Address Liberal, Kansas

STATE OF Kansas, COUNTY OF Seward, ss.
W.F. McKeen (employee of owner) or (owner or operator) of the above-described

well, being first duly sworn on oath, says: That I have knowledge of the facts, statements, and matters herein contained and the log of the above-described well as filed and that the same are true and correct. So help me God.

(Signature) W.F. McKeen

Box 1137 Liberal, Kansas
(Address)

SUBSCRIBED AND SWORN TO before me this 9th day of October, 1964

MY COMMISSION EXPIRES
DEC. 8, 1967

Patricia J. Jackson
Notary Public.

My commission expires _____

BASSETT & LIGHT et al #1

WELL RECORD:

LOCATION:

C NW SE Section 36-34S-33W
Seward County, Kansas

Commenced: 9-10-64
Completed: 9-23-64
(Rotary)

CONTRACTOR:

Graham-Michaelis Drilling Co.
Liberal Division
P. O. Box 1294
Liberal, Kansas

CASING RECORD:

49 Joints 24# 8-5/8" Casing
Cemented w/600 sx Pozmix 2% cc,
200 sx NA-5 and cemented thru 1 1/4"
150' w/100 sx Pozmix 2% cc

RECEIVED
STATE CORPORATION COMMISSION

OCT 12 1964

CONSERVATION DIVISION
Wichita, Kansas

	<u>LOG</u>	
Sand & Shale	0 -	930
Sand & Red Bed	930 -	1480
Red Bed & Anhy	1480 -	1530
Anhy	1530 -	1552
Anhy & Red Bed	1552 -	1875
Shale & Shells	1875 -	2330
Shale & Lime	2330 -	3073
Lime	3073 -	3200
Lime & Shale	3200 -	3578
Lime	3578 -	3775
Lime & Shale	3775 -	4700
Lime	4700 -	4973
Lime & Shale	4973 -	5455
Lime	5455 -	5550
Lime & Shale	5550 -	6280

6280' - Total Rotary Depth

The undersigned, Graham-Michaelis Drilling Company, Liberal Division, certifies that the above log is a true and correct copy of the formations encountered in drilling the above mentioned well, as taken from the Daily Drilling Report.

GRAHAM-MICHAELIS DRILLING COMPANY
LIBERAL DIVISION

By H. R. Michaelis
H. R. Michaelis