


STATE OF KANSAS
STATE CORPORATION COMMISSION

WELL PLUGGING RECORD

Give All Information Completely
Make Required Affidavit
Mail or Deliver Report to
Conservation Division
State Corporation Comm.
245 North Water
Wichita, KS 67202

Pratt County, Sec. 22 Twp. 27S Rge. 15W ~~RXX~~
Location as "NE/CNW 1/4 SW 1/4" or footage from lines _____
C SE NE
Lease Owner Hummon & Ropfogel
Lease Name Deal Well No. 1
Office Address 400 One Main Place, Wichita, Kansas
Character of Well (Completed as Oil, Gas or Dry Hole) _____

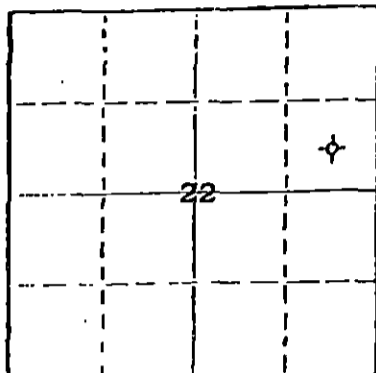

Locate well correctly on above
Section Plat

Dry Hole
Date Well completed March 10, 1980
Application for plugging filed March 10, 1980
Application for plugging approved March 10, 1980
Plugging commenced March 10, 1980
Plugging completed March 10, 1980
Reason for abandonment of well or producing formation _____

Dry Hole
If a producing well is abandoned, date of last production _____ 19____

Was permission obtained from the Conservation Division or
its agents before plugging was commenced? Yes

Name of Conservation Agent who supervised plugging of this well Wm. T. Owen
Producing formation _____ Depth to top _____ Bottom _____ Total Depth of Well 4600
Show depth and thickness of all water, oil and gas formations.

OIL, GAS OR WATER RECORDS

CASING RECORD

FORMATION	CONTENT	FROM	TO	SIZE	PUT IN	PULLED OUT
		0'	367'	8-5/8"	360.92'	None

Describe in detail the manner in which the well was plugged, indicating where the mud fluid was placed and the method or methods used in introducing it into the hold. If cement or other plugs were used, state the character of same and depth placed, from _____ feet to _____ feet for each plug set.

Plugged with 50 sacks cement at 360',
10 sacks cement at 40', 5 sacks cement
in rat hole.

(If additional description is necessary, use BACK of this sheet)

Name of Plugging Contractor Allied Cementing Co.

STATE OF KANSAS COUNTY OF SEDGWICK, ss.
John D. Knightley Agent (employee of owner) or (owner or operator)
of the above-described well, being first duly sworn on oath, says: That I have knowledge of the facts, statements, and matters herein contained and the log of the above-described well as fact and that the same are true and correct. So help me God.

(Signature) [Signature]
221 S. Broadway, Wichita, Kansas 67202
(Address)

SUBSCRIBED AND SWORN TO before me this 25th day of March, 1980



My commission expires March 12, 1983

[Signature] Notary Public.
RECEIVED
STATE CORPORATION COMMISSION

MAR 26 1980
3-26-80
CONSERVATION DIVISION
Wichita, Kansas

Hummon & Ropfogel
400 One Main Place
Wichita, Kansas 67202

Deal #1
C SE NE Sec. 22-27S-15W
Pratt County, Kansas

Contractor: D. R. Lauck Oil Company, Inc.
221 S. Broadway, Suite 400
Wichita, Kansas 67202

Commenced: February 28, 1980
Completed: March 10, 1980

Drillers Log

Sand	250
Red Bed	980
Anhydrite	991
Red Bed & Shale	2005
Shale & Shells	3250
Shale & Lime	4020
Lime & Shale	4130
Lime	4470
Lime & Sand	4490
Shale & Lime	4540
Sand & Shale	4600 RTD

RECEIVED
STATE CORPORATION COMMISSION

MAR 26 1980

CONSERVATION DIVISION
Wichita, Kansas