


STATE OF KANSAS
STATE CORPORATION COMMISSION

Form CP-4

WELL PLUGGING RECORD

Give All Information Completely
Make Required Affidavit
Mail or Deliver Report to:
Conservation Division
State Corporation Commission
212 No. Market
Wichita, Kansas 67202

NORTH

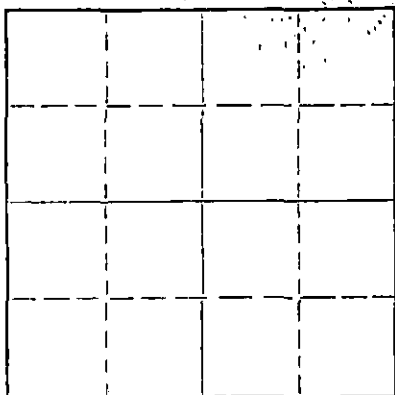

Locate well correctly on above
Section Plat

Pratt County, Sec. 22 Twp. 27 Rge. 15 (E) (W)
Location as "NE/CNW&SW" or footage from lines SE SE NE
Lease Owner Raymond Oil Co., Inc.
Lease Name Covey Deal #2 Well No.
Office Address Wichita, Kansas 67202
Character of Well (completed as Oil, Gas or Dry Hole)
Date well completed 19____
Application for plugging filed 19____
Application for plugging approved 19____
Plugging commenced 10/16/70 19____
Plugging completed 10/24/70 19____
Reason for abandonment of well or producing formation depleted.

If a producing well is abandoned, date of last production 19____
Was permission obtained from the Conservation Division or its agents before plugging was commenced? YES

Name of Conservation Agent who supervised plugging of this well Biberstein
Producing formation _____ Depth to top _____ Bottom _____ Total Depth of Well 4713 Feet
Show depth and thickness of all water, oil and gas formations.

OIL, GAS OR WATER RECORDS

CASING RECORD

FORMATION	CONTENT	FROM	TO	SIZE	PUT IN	PULLED OUT
				8-5/8	320	none
				5 1/2"	4710	2697'

Describe in detail the manner in which the well was plugged, indicating where the mud fluid was placed and the method or methods used in introducing it into the hole. If cement or other plugs were used, state the character of same and depth placed, from _____ feet to _____ feet for each plug set.

Sanded to 4470', dumped 5 sacks of cement. Loaded hole, shot pipe at 4010', 3785', 3019', 2886', 2786', 2695', worked pipe loose and pulled 85 joints. Set rock bridge at 310 to 300' and dumped 5 sacks of cement. Bailed fluid down to top of plug and dumped 4 yards ready mix.

PLUGGING COMPLETE.

RECEIVED
STATE CORPORATION COMMISSION
NOV 12 1970
CONSERVATION DIVISION
Wichita, Kansas

(If additional description is necessary, use BACK of this sheet)
Name of Plugging Contractor KNIGHT CASING PULLING CO., INC.
Address CHASE, KANSAS

STATE OF KANSAS, COUNTY OF RICE, ss.
NOEL J. KNIGHT (employee of owner) or (owner or operator) of the above-described well, being first duly sworn on oath, says: That I have knowledge of the facts, statements, and matters herein contained and the log of the above-described well as filed, and that the same are true and correct. So help me God.

(Signature) Noel Knight
CHASE, KANSAS (Address)

Subscribed and sworn to before me this 5th day of November, 1970

My commission expires 2/15/71

Margaret Melcher
Notary Public.

KANSAS GEOLOGICAL SOCIETY
 KANSAS WELL LOG BUREAU - KANSAS WELL SAMPLE BUREAU
 KANSAS GEOLOGICAL SOCIETY BUILDING
 808 EAST MURDOCK - WICHITA, KANSAS

COPY

COMPANY J.E. NEWMAN

FARM Covey-Deal

NO. 2

SEC. 22 T. 27 R. 15W
 LOC. SE SE NE

TOTAL DEPTH 4713'

COMM. 2-24-62

COMP. 8-9-62

COUNTY Pratt

KANSAS

BHPT OR TREATED

CONTRACTOR Cherokee Drlg.

ISSUED 12-10-66

CASING

20	10	
15	8 5/8	320' w/250 sx cem.
12	6	
13	5 1/2	4710' w/250 sx cem.

ELEVATION 2077' KB

FIGURES INDICATE BOTTOM OF FORMATIONS

PRODUCTION 4 PT COF
 1900 MCF/GPD: SIP 1300#/d
 Kind Snd 4490-4504

COMPLETE DRILLERS LOG NOT AVAILABLE.

TOPS: SCOUT	
Heebner	3840
Brown Lime	3992
Lansing	4010
Cherokee Sand	4453
Mississippi	4478
Kinderhook Shale	4490
Kinderhook Sand	4497
Conglomerate	4530
Viola	4538
Simpson Shale	4684
Simpson SAnd	4700

RECEIVED
 STATE CORPORATION COMMISSION
 OCT 15 1970
 CONSERVATION DIVISION
 Wichita, Kansas