


STATE OF KANSAS  
STATE CORPORATION COMMISSION  
200 Colorado Derby Bldg.  
Wichita, Kansas 67202

Form CP-4  
Rev. 12-15-80

WELL PLUGGING RECORD

Give All Information Completely  
Make Required Affidavit

COUNTY Pratt SEC. 36 TWP. 28S RGE. 12W E/W  
Location as in quarters or footage from lines:  
350' S of C S/2

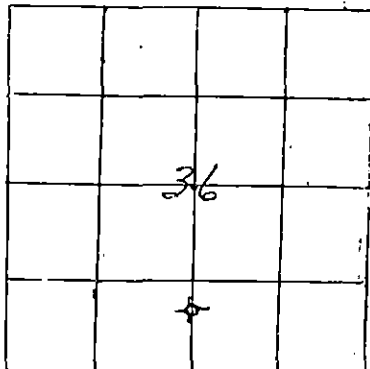

Locate Well  
correctly on above  
Section Platt.

Lease Owner Hummon Corporation  
Lease Name House Well No. 1  
Office Address 400 One Main Place, Wichita, Kansas 67202  
Character of Well (Completed as Oil, Gas or Dry Hole): Dry Hole  
Date Well Completed 11/22/81  
Application for plugging filed 12/3/81  
Plugging commenced 11/22/81  
Plugging completed 11/22/81  
Reason for abandonment of well or producing formation Dry Hole

Was permission obtained from the Conservation Division or it's  
Agent's before plugging was commenced? Yes

Name of Conservation Agent who supervised plugging of this well Maurice V. Leslie  
Producing formation \_\_\_\_\_ Depth to top \_\_\_\_\_ bottom \_\_\_\_\_ T.D. 4560'  
Show depth and thickness of all water, oil and gas formations.

OIL, GAS OR WATER RECORDS Casing Record

Formation	Content	From	To	Size	Put in	Pulled Out
		0'	345'	8-5/8"	338.76'	None

Describe in detail the manner in which the well was plugged, indicating where the mud  
fluid was placed and the method or methods used in introducing it into the hold. If cement  
or other plugs were used, state the character of same and depth placed, from \_\_\_\_\_ feet  
to \_\_\_\_\_ feet for each plug set.


Plugged with 50 sacks cement at 520';  
40 sacks cement at 320'; 1/2 sack bulls,  
plug and 10 sacks cement at 40'; and  
10 sacks cement in rat hole.

RECEIVED  
STATE CORPORATION COMMISSION  
DEC 15 1981  
12-04-81  
CONSERVATION DIVISION  
Wichita, Kansas

(If additional description is necessary, use BACK of this sheet)  
Name of Plugging Contractor Allied Cementing Co.

STATE OF KANSAS COUNTY OF SEDGWICK, ss.  
John D. Knightley, Agent (employee of owner) or (owner or operator) of the  
above-described well, being first duly sworn on oath, says: That I have knowledge of the  
facts, statements, and matters herein contained and the log of the above-described well as  
filed and that the same are true and correct. So help me God.

(Signature) [Signature]  
221 S. Broadway, Wichita, KS 67202  
(Address)

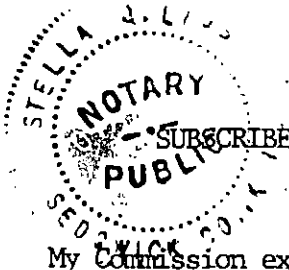

SUBSCRIBED AND SWORN TO before me this 3rd day of December, 19 81

Stella J. Lipps  
Notary Public.

My Commission expires: March 12, 1983

Hummon Corporation  
400 One Main Place  
Wichita, Kansas 67202

-

House #1  
350' S of C S/2 Sec. 36-28S-12W  
Pratt County, Kansas

Contractor: D. R. Lauck Oil Company, Inc.  
221 S. Broadway, Suite 400  
Wichita, Kansas 67202

Commenced: November 12, 1981  
Completed: November 22, 1981

Drillers Log

---

Sand	134
Red Bed	282
Shale	348
Red Bed	430
Red Bed & Shale	1460
Shale	3860
Shale & Lime	4005
Lime	4512
Sand	4519
Lime	4523
Sand	4560 RTD

RECEIVED  
STATE CORPORATION COMMISSION  
DEC - 4 1981  
CONSERVATION DIVISION  
Wichita, Kansas