


STATE OF KANSAS
STATE CORPORATION COMMISSION

Form CP-4

Give All Information Completely
Make Required Affidavit
Mail or Deliver Report to:
Conservation Division
State Corporation Commission
212 No. Market
Wichita, Kansas 67202

WELL PLUGGING RECORD

NORTH

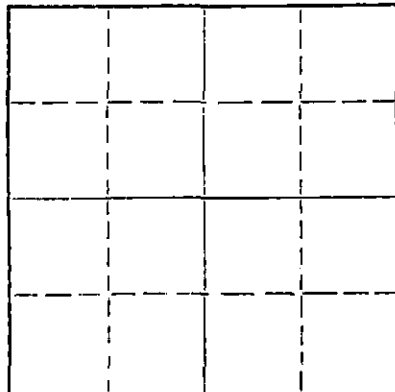

Locate well correctly on above
Section Plat

CLARK County. Sec. 12 Twp. 34 Rge. (E) 23 (W)
Location as "NE/CNW*SW*" or footage from lines NE SE
Lease Owner RAN RICKS JR
Lease Name NELSON Well No. 1
Office Address 425 Cravens Building, Oklahoma City, Oklahoma 73102
Character of Well (completed as Oil, Gas or Dry Hole) Dry hole
Date well completed 8/30 1972
Application for plugging filed 8/30 19 72
Application for plugging approved 8/30 19 72
Plugging commenced 8/30 19 72
Plugging completed 8/30 19 72
Reason for abandonment of well or producing formation Dry Hole

If a producing well is abandoned, date of last production 19
Was permission obtained from the Conservation Division or its agents before plugging was commenced? yes

Name of Conservation Agent who supervised plugging of this well EDGAR EVIS
Producing formation _____ Depth to top _____ Bottom _____ Total Depth of Well 5602 Feet
Show depth and thickness of all water, oil and gas formations.

OIL, GAS OR WATER RECORDS

CASING RECORD

FORMATION	CONTENT	FROM	TO	SIZE	PUT IN	PULLED OUT
Topsoil, sand, redbed		0	822	8 5/8	822	-0-

Describe in detail the manner in which the well was plugged, indicating where the mud fluid was placed and the method or methods used in introducing it into the hole. If cement or other plugs were used, state the character of same and depth placed, from _____ feet to _____ feet for each plug set.

1st plug - 35 sx @ 780
2nd plug - 15 sx @ 45'
2 sax rsy hole

RECEIVED
STATE CORPORATION COMMISSION
SEP 7 1972
CONSERVATION DIVISION
Wichita, Kansas


(If additional description is necessary, use BACK of this sheet)
Name of Plugging Contractor GABBERT-JONES, INC.
Address 830 Sutton Place, Wichita, Kansas

STATE OF KANSAS, COUNTY OF SEDGWICK, ss.
GABBERT-JONES, INC. (employee of owner) or (owner or operator) of the above-described well, being first duly sworn on oath, says: That I have knowledge of the facts, statements, and matters herein contained and the log of the above-described well as filed and that the same are true and correct. So help me God.

(Signature) Jack W. Gabbert, Exec. Vice President
830 Sutton Place, Wichita, Kansas (Address)

Subscribed and sworn to before me this 6 day of September, 1972

My commission expires Nov. 29, 1975

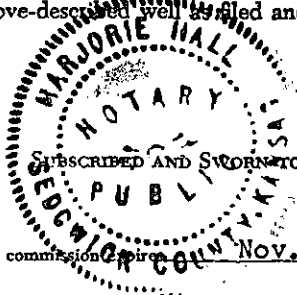

Marjorie Hall
Notary Public.

GABBERT-JONES, INC.
WICHITA, KANSAS
DRILLERS' WELL LOG

NELSON #1
NE SE, Section 12-34S-23W
Clark County, Kansas

Commenced: August 16, 1972
Completed: August 30, 1972

OPERATOR: RAN RICKS, JR.

RECEIVED
STATE CORPORATION COMMISSION

SEP 7 1972

CONSERVATION DIVISION
Wichita, Kansas

Depth		Formation	Remarks
From	To		
0	30	Sand	Ran 20 joints of used 24# 8' 5/8" csg. set @ 822' centralizer @ 800'-700' cemented w/250 sks Howcolite w/2% CC @ 200 sks common w/3% CC. P.D. @ 12:15 AM 8/17/72 Cement Circ. Job by Halco
30	600	Sand-redbed	
600	890	Redbed	
890	1595	Redbed-shale	
1595	1950	Shale-shells	
1950	2295	Shale-lime	
2295	4640	Lime-shale	
4640	4785	Lime	
4785	4885	Lime-shale	
4885	5602	Lime	
5602	TD		DRY AND ABANDONED

I, James S. Sutton, II, certify this is a correct copy of the Drillers' Log for the well drilled in the NE SE, Section 12-34S-23W, Clark County, Kansas, to the best of my knowledge and belief.

James S. Sutton, II
James S. Sutton, II

STATE OF KANSAS)
) SS
COUNTY OF SEDGWICK)

Before me, the undersigned, a Notary Public within and for said County and State, on this 5th day of September, 1972, personally appeared James S. Sutton, II, to me personally known to be the identical person who executed the within and foregoing instrument and acknowledged to me that he executed the same as his free and voluntary act and deed for the uses and purposes therein set forth.

IN WITNESS WHEREOF, I have hereunto set my hand and official seal the day and year last above written.

Marjorie Hall
Marjorie Hall, Notary Public

My Commission expires
November 29, 1975

