

STATE OF KANSAS
STATE CORPORATION COMMISSION


Form CP-4

Give All Information Completely
Make Required Affidavit
Mail or Deliver Report to:
Conservation Division
State Corporation Commission

WELL PLUGGING RECORD

P. O. Box 17027
Wichita, Kansas 67217
North

Clark County, Sec. 10 Twp. 34S Rge. 23 (E) X (W)

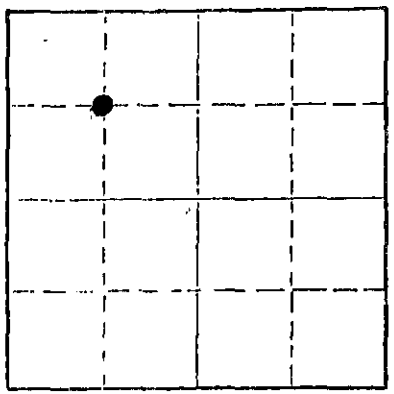

Locate well correctly on above Section Plot

Location as "NE/CNW/SW" or footage from lines C-NW/4
Lease Owner Ascot Oils, Inc.
Lease Name SHAW #1 Well No. 1
Office Address 980 Jordan - Shreveport, LA 71105
Character of Well (completed as Oil, Gas or Dry Hole) Dry Hole
Date well completed May 26, 19 74
Application for plugging filed 19
Application for plugging approved 19
Plugging commenced June 7, 19 74
Plugging completed June 7, 19 74
Reason for abandonment of well or producing formation Dry Hole

If a producing well is abandoned, date of last production 19
Was permission obtained from the Conservation Division or its agents before plugging was commenced? Yes

Name of Conservation Agent who supervised plugging of this well
Producing formation Depth to top Bottom Total Depth of Well 6509 Feet
Show depth and thickness of all water, oil and gas formations.

OIL, GAS OR WATER RECORDS				CASING RECORD		
FORMATION	CONTENT	FROM	TO	SIZE	PUT IN	PULLED OUT
Chester	No Shows	5430	5684	8 5/8	415'	None
St. Genevieve		5684	6445			
Warsaw		6445	6500			
Dolomitic Limestone		6500	6509			

Describe in detail the manner in which the well was plugged, indicating where the mud fluid was placed and the method or methods used in introducing it into the hole. If cement or other plugs were used, state the character of same and depth placed, from feet to feet for each plug set.

No shows of gas or oil
No test made or casing run
(other than surface casing)
1 Plug set
75 Sacks of Cement

RECEIVED
STATE CORPORATION COMMISSION
OCT 29 1974
CONSERVATION DIVISION
Wichita, Kansas

(If additional description is necessary, use BACK of this sheet)
Name of Plugging Contractor Halliburton
Address P.O. Drawer 1431 - Duncan, Oklahoma

STATE OF LOUISIANA Parish CADDO, ss.
I, Keith Houser (employee of owner) or (owner or operator) of the above-described

well, being first duly sworn on oath, says: That I have knowledge of the facts, statements, and matters herein contained and the log of the above-described well as filed and that the same are true and correct. So help me God.

(Signature) Keith Houser
P. O. Box 5248-Shreveport, LA 71105
(Address)

SUBSCRIBED AND SWORN TO before me this 24th day of October, 19 74

My commission expires With Life

DOROTHY JANE SHAW, Notary Public
Caddo Parish, Louisiana
My Commission Is For Life