

STATE OF KANSAS  
STATE CORPORATION COMMISSION

WELL PLUGGING RECORD

Give All Information Completely  
Make Required Affidavit  
Mail or Deliver Report to:  
Conservation Division  
State Corporation Commission  
800 Biting Building  
Wichita, Kansas

Meade County, Sec. 2 Twp. 34S Rge. 30 (E) (W)

Location as "NE/CNW&SW" or footage from lines C NW/4 of SW/4

Lease Owner The Hamrock Oil and Gas Corporation

Lease Name John I. Schell Well No. 1

Office Address Box 631, Amarillo, Texas

Character of Well (completed as Oil, Gas or Dry Hole) Dry Hole

Date well completed September 12, 19 55

Application for plugging filed September 12, 19 55

Application for plugging approved September 12, 19 55


Plugging commenced September 13, 19 55

Plugging completed September 13, 19 55

Reason for abandonment of well or producing formation Dry Hole

If a producing well is abandoned, date of last production Dry Hole 19

Was permission obtained from the Conservation Division or its agents before plugging was commenced? Yes

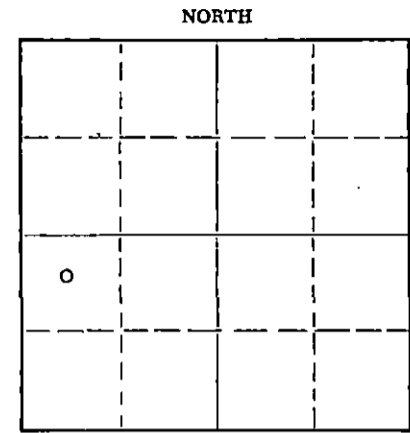

Name of Conservation Agent who supervised plugging of this well Merle Rives

Producing formation None Depth to top Bottom Total Depth of Well 5,983 Feet

Show depth and thickness of all water, oil and gas formations.

OIL, GAS OR WATER RECORDS

CASING RECORD

FORMATION	CONTENT	FROM	TO	SIZE	PUT IN	PULLED OUT
Water sand & Gravel	Fresh water	0	575	13 3/8"	640	None
				9 5/8"	2,667	None

Describe in detail the manner in which the well was plugged, indicating where the mud fluid was placed and the method or methods used in introducing it into the hole. If cement or other plugs were used, state the character of same and depth placed, from feet to feet for each plug set.

- 5,983' to 600' Heavy mud
- 600' Halliburton plug (9 5/8")
- 600' to 525' Cement (30 sacks)
- 525' to 38' Heavy mud
- 38' Halliburton plug (9 5/8")
- 38' to 0' Cement (15 sacks).

RECEIVED  
STATE CORPORATION COMMISSION  
SEP 14 1955  
CONSERVATION DIVISION  
WICHITA, KANSAS

Name of Plugging Contractor Halliburton Oil Well Cementing Company Liberal, Kansas

STATE OF TEXAS, COUNTY OF POTTER, ss. Dan P. Long (employee of owner) or (owner or operator) of the above-described well, being first duly sworn on oath, says: That I have knowledge of the facts, statements, and matters herein contained and the log of the above-described well as filed and that the same are true and correct. So help me God.

(Signature) Dan P. Long  
Box 631, Amarillo, Texas (Address)

SUBSCRIBED AND SWORN to before me this 13th day of September, 19 55

(Signature) Notary Public  
Potter County, Texas

My commission expires

PLUGGING  
FILE SEC 2 T 34 R 30W  
BOX PAGE 149 LINE 41