


WELL PLUGGING RECORD

Give All Information Completely
Make Required Affidavit
Mail or Deliver Report to:
Conservation Division
State Corporation Commission
212 North Market, Insurance Bldg.
Wichita, Kansas

Meade County. Sec. 24 Twp. 34 Rge. 28 (X) (W)
Location as "NE/CNW/SW" or footage from lines C NE SW
Lease Owner Panhandle Eastern Pipe Line Company
Lease Name Leonard Well No. 1-24
Office Address P. O. Box 979, Liberal, Kansas
Character of Well (completed as Oil, Gas or Dry Hole) Dry Hole
Date well completed --- 19
Application for plugging filed July 27 19 60
Application for plugging approved July 26 19 60
Plugging commenced July 27 19 60
Plugging completed July 27 19 60
Reason for abandonment of well or producing formation Dry Hole

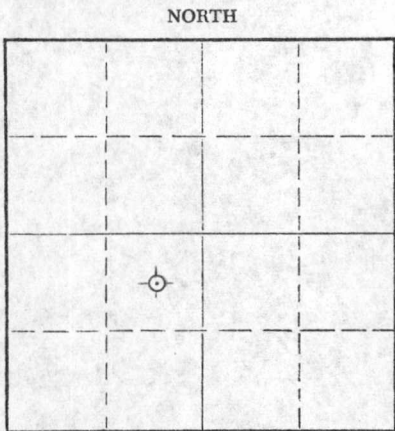

Locate well correctly on above Section Plat

If a producing well is abandoned, date of last production --- 19
Was permission obtained from the Conservation Division or its agents before plugging was commenced? Verbal approval by Mr. LaKamp

Name of Conservation Agent who supervised plugging of this well W. L. LaKamp Jr.
Producing formation --- Depth to top --- Bottom --- Total Depth of Well 3,205 Feet
Show depth and thickness of all water, oil and gas formations.

OIL, GAS OR WATER RECORDS

CASING RECORD

FORMATION	CONTENT	FROM	TO	SIZE	PUT IN	PULLED OUT
				8-5/8	417'	None
	N O N E					

Describe in detail the manner in which the well was plugged, indicating where the mud fluid was placed and the method or methods used in introducing it into the hole. If cement or other plugs were used, state the character of same and depth placed, from --- feet to --- feet for each plug set.

Spotted 30sacks common cement at 3,010 feet. Filled with mud to 448 feet. Spotted 30 sacks cement at 448 feet. Filled with mud to 35 feet. Spotted 15 sacks cement from 35 feet to surface.

RECEIVED
STATE CORPORATION COMMISSION

AUG 4 1960

CONSERVATION DIVISION
Wichita, Kansas

(If additional description is necessary, use BACK of this sheet)

Name of Plugging Contractor Earl F. Wakefield
Address 307-8 Union National Bank Building, Wichita, Kansas

STATE OF Kansas, COUNTY OF Seward, ss.
I, R. L. O'Shields (employee of owner) or (~~owner or operator~~) of the above-described well, being first duly sworn on oath, says: That I have knowledge of the facts, statements, and matters herein contained and the log of the above-described well as filed and that the same are true and correct. So help me God.

(Signature) R. L. O'Shields
Manager, Drilling and Production
P. O. Box 979, Liberal, Kansas
(Address)

SUBSCRIBED AND SWORN to before me this 2nd day of August, 19 60

My Commission Expires
December 8, 1963

My commission expires

Patricia Jackson
Notary Public.



