


STATE OF KANSAS
STATE CORPORATION COMMISSION

Give All Information Completely
Make Required Affidavit
Mail or Deliver Report to:
Conservation Division
State Corporation Commission
P. O. Box 17027
Wichita, Kansas 67217
NORTH

WELL PLUGGING RECORD

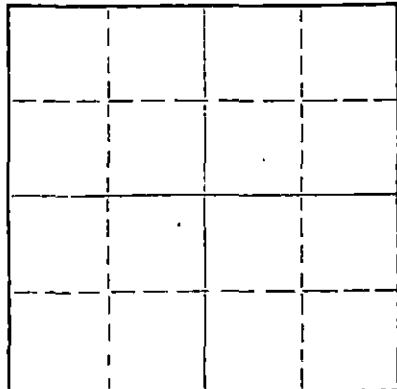

Locate well correctly on above
Section Plat

Meade County, Sec. 25 Twp. 34 S Rge. 30 (E) W (W)
Location as "NE/CNW/SW" or footage from lines 1250 EL & SL
Lease Owner Cotton Petroleum Corporation
Lease Name Adams Well No. 1
Office Address 2121 South Columbia; Tulsa, Oklahoma 74114
Character of Well (completed as Oil, Gas or Dry Hole) _____
Date well completed 10/22/71 19____
Application for plugging filed 1/17/74 19____
Application for plugging approved 1/21/74 19____
Plugging commenced January 24 1974
Plugging completed January 30 1974
Reason for abandonment of well or producing formation No longer producing
at commercial rates
If a producing well is abandoned, date of last production 1/74 19____
Was permission obtained from the Conservation Division or its agents before plugging was com-
menced? Yes

Name of Conservation Agent who supervised plugging of this well _____
Producing formation Morrow Depth to top 5900 Bottom 5951 Total Depth of Well 6488 Feet
Show depth and thickness of all water, oil and gas formations.

OIL, GAS OR WATER RECORDS

CASING RECORD

FORMATION	CONTENT	FROM	TO	SIZE	PUT IN	PULLED OUT
Morrow		5900	5951	4 1/2	6116'	2408'
				8 5/8	659	None

Describe in detail the manner in which the well was plugged, indicating where the mud fluid was placed and the method or methods used in introducing it into the hole. If cement or other plugs were used, state the character of same and depth placed, from _____ feet to _____ feet for each plug set.
Shot casing at 2408'. Spotted 50 sacks of cement displaced by pump method from 709' to 609'. Capped 8 5/8" surface with 15 sacks of cement 3' to 33' welded on steel plate with date & I.D.

RECEIVED
STATE CORPORATION COMMISSION
FEB 14 1974
CONSERVATION DIVISION
Wichita, Kansas

(If additional description is necessary, use BACK of this sheet)
Name of Plugging Contractor LILLARD CASING PULLING, INC.
Address P.O. Box 962; Woodward, Oklahoma 73801

STATE OF Oklahoma, COUNTY OF Woodward, ss.
Lowell L. Lillard (employee of owner) or (owner or operator) of the above-described well, being first duly sworn on oath, says: That I have knowledge of the facts, statements, and matters herein contained and the log of the above-described well as filed and that the same are true and correct. So help me God.

(Signature) Lowell Lillard

(Address)

SUBSCRIBED AND SWORN to before me this 7th day of February, 1974

Lindie Lillard

Notary Public.

My commission expires 1-11-76

15-119-20079-0000

KANSAS DRILLERS LOG

S. 25 T. 34S R. 30 ^W

API No. 15 _____
County _____ Number _____

Loc. NE-NW-SW

County Meade

Operator
Cotton Petroleum Corporation

Address
2121 S. Columbia, Tulsa, Oklahoma 74114


Well No. 1 Lease Name Adams A

Footage Location
1250 feet from (X) (S) line 1390 feet from (X) (W) line

Principal Contractor Service Drilling Company Geologist _____

Spud Date 9/2/71 Total Depth 6488 P.B.T.D. 6488

Date Completed 10/22/71 Oil Purchaser Derby Refining Co.

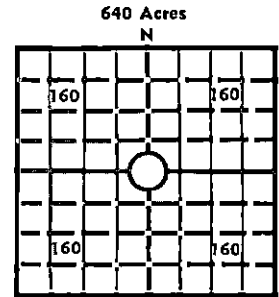

Elev.: Gr. _____

DF 2619 KB _____

CASING RECORD

Report of all strings set— surface, intermediate, production, etc.

Purpose of string	Size hole drilled	Size casing set (in O.D.)	Weight lbs/ft.	Setting depth	Type cement	Sacks	Type and percent additives
Surface	12 1/4"	8 5/8"	23#	659	Cl. H.	350	60% gel 2% CaCl
Production	7 7/8"	4 1/2#	9.5 10.5	6116	50/50 poz.	400	18% Salt

LINER RECORD

PERFORATION RECORD

Top, ft.	Bottom, ft.	Sacks cement	Shots per ft.	Size & type	Depth interval
			1	1 9/16 Hyperjet	5932-38 5947-51
					5900-08

TUBING RECORD

Size	Setting depth	Packer set at
2 3/8"	5042'	None

ACID, FRACTURE, SHOT, CEMENT SQUEEZE RECORD

Amount and kind of material used	Depth interval treated
1500 gals 7 1/2% spearhead acid w/3% gelled acid pad	5900-5951
Frac w/10000 gals 3% gelled acid water w/14000# 20/40 Sd and 2000# 10/20 Sd.	

INITIAL PRODUCTION

Date of first production 10/22/71 Producing method (flowing, pumping, gas lift, etc.) Flowing

RATE OF PRODUCTION PER 24 HOURS
Oil 203 bbls. Gas 619 MCF Water 0 bbls. Gas-oil ratio 3049 CFPB

Disposition of gas (vented, used on lease or sold) Vented Producing interval(s) 5900-5951

INSTRUCTIONS: As provided in KCC Rule 82-2-125, within 90 days after completion of a well, one completed copy of this Drillers Log shall be transmitted to the State Geological Survey of Kansas, 4150 Monroe Street, Wichita, Kansas 67209. Copies of this form are available from the Conservation Division, State Corporation Commission, 3830 So. Meridian (P.O. Box 17027), Wichita, Kansas 66217. Phone AC 316-522-2206. If confidential custody is desired, please note Rule 82-2-125. Drillers Logs will be on open file in the Oil and Gas Division, State Geological Survey of Kansas, Lawrence, Kansas 66044.

RECEIVED
STATE CORPORATION COMMISSION
APR 8 - 1974
CONSERVATION DIVISION
Wichita, Kansas

Operator		DESIGNATE TYPE OF COMP.: OIL, GAS, DRY HOLE, SWDW, ETC.:
Well No. 1	Lease Name Adams A	Oil
S <u>25</u> T <u>34S</u> R <u>30</u> E W		


WELL LOG

Show all important zones of porosity and contents thereof; cored intervals, and all drill-stem tests, including depth interval tested, cushion used, time tool open, flowing and shut-in pressures, and recoveries.

SHOW GEOLOGICAL MARKERS, LOGS RUN, OR OTHER DESCRIPTIVE INFORMATION.

FORMATION DESCRIPTION, CONTENTS, ETC.	TOP	BOTTOM	NAME	DEPTH
Red Bed & Sand	0	661	Morrow	5900
Sand & Red Bed.	661	1323		
Shale, Shells, Anhydrite & Lime	1323	2517		
Lime & Shale	2517	2983		
Lime, Shale Dolomite	2983	3385		
Lime, Shale & Dolomite	3385	3850		
Shale	3850	4450		
Lime & Shale	4450	4716		
Lime & Shale	4716	5115		
Lime & Shale	5115	5506		
Shale & Lime	5506	5708		
Shale & Lime	5708	5955		
Lime & Shale	5955	6181		
Lime & Shale	6181	6299		
Lime	6299	6336		
Lime	6336	6459		
Lime	6459	6488		

USE ADDITIONAL SHEETS, IF NECESSARY, TO COMPLETE WELL RECORD.

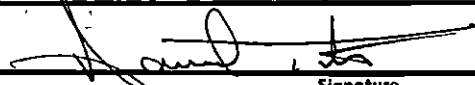Date Received	 Signature
	Production Administrator Title
	4/4/74 Date