

STATE OF KANSAS
STATE CORPORATION COMMISSION

Form CP-4

WELL PLUGGING RECORD

Give All Information Completely
Make Required Affidavit
Mail or Deliver Report to:
Conservation Division
State Corporation Commission
212 No. Market
Wichita, Kansas

Meade County, Sec. 22 Twp. 34S Rge. 30 (E) (W)

Location as "NE/CNW%SW%" or footage from lines NE NE

Lease Owner Thomas, Inc.

Lease Name Adams Well No. 1-22

Office Address Box 1177, Liberal, Kansas 67901

Character of Well (completed as Oil, Gas or Dry Hole) Dry Hole

Date well completed 1-21 19 69

Application for plugging filed 1-22 19 69

Application for plugging approved 19 69


Plugging commenced 1-21 19 69

Plugging completed 1-21 19 69

Reason for abandonment of well or producing formation Dry

If a producing well is abandoned, date of last production 19

Was permission obtained from the Conservation Division or its agents before plugging was commenced? Yes

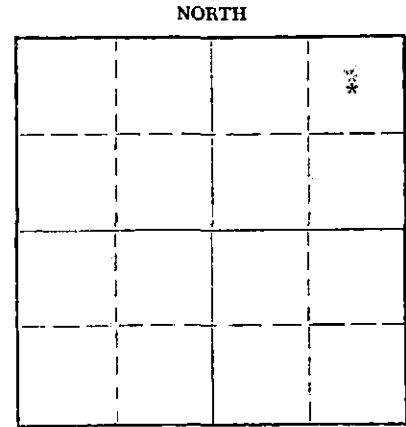

Locate well correctly on above Section Plat

Name of Conservation Agent who supervised plugging of this well Edgar J. Eves

Producing formation St. Louis Depth to top 6446 Bottom Total Depth of Well 6645 Feet

Show depth and thickness of all water, oil and gas formations.

OIL, GAS OR WATER RECORDS

CASING RECORD

FORMATION	CONTENT	FROM	TO	SIZE	PUT IN	PULLED OUT
Surface Sands	Fresh Water	90	300	8 5/8	1512	None

Describe in detail the manner in which the well was plugged, indicating where the mud fluid was placed and the method or methods used in introducing it into the hole. If cement or other plugs were used, state the character of same and depth placed, from feet to feet for each plug set.

Mud to 900' and Pump 35 sx. cement

Mud to 45' and Pump 15 sx. cement

RECEIVED
STATE CORPORATION COMMISSION
JAN 23 1969
CONSERVATION DIVISION
Wichita, Kansas

(If additional description is necessary, use BACK of this sheet)

Name of Plugging Contractor Lohmann - Johnson Drilling Co.

Address 320 Indiana Bank Bldg., Evansville, Ind.

STATE OF Kansas, COUNTY OF Dewar, ss. (employee of owner) or (owner or operator) of the above-described well, being first duly sworn on oath, says: That I have knowledge of the facts, statements, and matters herein contained and the log of the above-described well as filed and that the same are true and correct. So help me God.

(Signature) Delwin P. Luch

(Address)

SUBSCRIBED AND SWORN to before me this 22nd day of January, 1969

My commission expires 11-5-70

Notary Public.

Form G

WELL RECORD



STATE OF KANSAS DEPARTMENT OF MINES AND MINERALS OIL AND GAS DIVISION

XXXXXXXXXX

Permit No. Oil or Gas Well Dry Hole (Kind)

THOMAS PETROLEUM CO
Address BOX 1177, LIBERAL, KANSAS
Farm ADAMS
Location Section 22-34S-30W
Well No. 1-22
District Meade
Drilling Commenced 12/26/68
Name of Contractor LOHMANN-JOHNSON DRILLING CO., INC
Address of Contractor 320 INDIANA BANK BLDG., EVANSVILLE, INDIANA
Casing and Used in Left In Tubing Drilling Well
Size 8 5/8" set @ 1512' w/450 Sks Cement
Perf. top
Perf. bottom

Table with 8 columns: Formation, Color, Hard or Soft, Top, Bottom, Oil, Gas & Coal or Water, Depth Found, Remarks. Rows include SURFACE, SAND & SHALE, LIME & SHALE, etc. Total depth 6645. DRY & ABANDONED - PLUGGED 1/21/69

RECEIVED STATE CORPORATION COMMISSION MAR 4 1969 CONSERVATION DIVISION Wichita, Kansas

THE UNDERSIGNED, LOHMANN-JOHNSON DRILLING CO., INC., HEREBY CERTIFIES THAT THE ABOVE IS A TRUE AND CORRECT LOG OF THE FORMATIONS ENCOUNTERED IN DRILLING THIS WELL IN ACCORDANCE WITH THE DAILY DRILLING REPORTS.

LOHMANN-JOHNSON DRILLING CO., INC
By G.B. Putman, Vice-President

Subscribed and sworn to before me this 21st day of February, 1969

Helen V. Fields, Notary Public
My Commission expires November 5, 1969