


Give All Information Completely
Make Required Affidavit
Mail or Deliver Report to:
Conservation Division
State Corporation Commission
211 No. Broadway
Wichita, Kansas

WELL PLUGGING RECORD

Meade County. Sec. 21 Twp. 34S Rge. 30 (E) W (W)
Location as "NE/CNWxSWx" or footage from lines C SW SW
Lease Owner Mallonee-Mahoney, Inc.
Lease Name Staples Well No. 1
Office Address 925 Sutton Place, Wichita, Kansas 67202
Character of Well (completed as Oil, Gas or Dry Hole) Dry Hole
Date well completed 2-13 1969
Application for plugging filed 2-13 1969
Application for plugging approved 2-13 1969
Plugging commenced 2-14 1969
Plugging completed 2-14 1969
Reason for abandonment of well or producing formation Dry Hole

NORTH

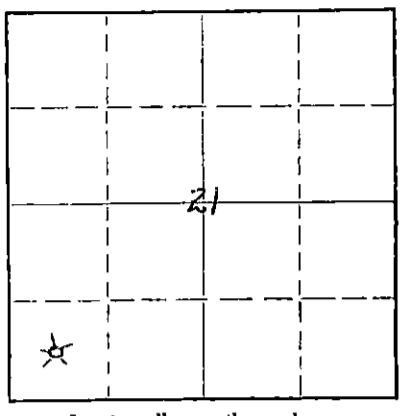

Locate well correctly on above
Section Plat

If a producing well is abandoned, date of last production _____ 19____
Was permission obtained from the Conservation Division or its agents before plugging was commenced? Yes

Name of Conservation Agent who supervised plugging of this well Ed Eves
Producing formation _____ Depth to top _____ Bottom _____ Total Depth of Well 6,450' KB Feet
Show depth and thickness of all water, oil and gas formations.

OIL, GAS OR WATER RECORDS

CASING RECORD

FORMATION	CONTENT	FROM	TO	SIZE	PUT IN	PULLED OUT

Describe in detail the manner in which the well was plugged, indicating where the mud fluid was placed and the method or methods used in introducing it into the hole. If cement or other plugs were used, state the character of same and depth placed, from _____ feet to _____ feet for each plug set.

Heavy Mud 6,450' to 900'; 35 sx Common Cement b y Halliburton 900' to 800'.
Heavy Mud 800' to 45', Rubber Plug, 15 sx Common Cement 45' to 0.

RECEIVED
STATE CORPORATION COMMISSION
FEB 17 1969
CONSERVATION DIVISION
Wichita, Kansas

(If additional description is necessary, use BACK of this sheet)

Name of Plugging Contractor Lohmann-Johnson Drilling Co., Inc.
Address 320 Indiana Bank Building, Evansville, Indiana 47700

STATE OF Kansas, COUNTY OF Seward, ss.

I, William F. Dean (employee of owner) or (owner or operator) of the above-described well, being first duly sworn on oath, says: That I have knowledge of the facts, statements, and matters herein contained and the log of the above-described well as filed and that the same are true and correct. So help me God.

(Signature) William F. Dean
Box 1257, Liberal, Kansas 67901
(Address)

SUBSCRIBED AND SWORN TO before me this 14th day of February, 1969


Form G

WELL RECORD

RECEIVED
STATE CORPORATION COMMISSION
FEB 28 1969
CONSERVATION DIVISION
Wichita, Kansas



STATE OF KANSAS
DEPARTMENT OF MINES AND MINERALS
OIL AND GAS DIVISION

~~XXXXXXXXXX~~
~~XXXXXXXXXX~~
~~XXXXXXXXXX~~

Permit No.

Oil or Gas Well Dry Hole
(Kind)

Company MALLONEE & MAHONEY
Address BOX 1257, LIBERAL, KANSAS
Farm STAPLES Acres ..
Location (waters) Section 21-34S-30W
Well No. 1 Elev.
District .. County Meade
Drilling Commenced 1-23-69
Drilling Completed 2-14-69
Name of Contractor LOHMANN-JOHNSON DRILLING CO., INC
Address of Contractor 320 INDIANA BANK BLDG., EVANSVILLE, INDIANA
Date Shot .. From .. To ..
With ..
Open flow /10ths Water in .. Inch
/10ths Merc. in .. Inch

Casing and Used in Left In Tubing
Drilling Well

Size	Kind of Packer
16
13
10	Size of
8 1/4 <u>1531' 8-5/8" set @ 1530' w/600 Skts</u>
6 3/4	Depth Set
5 3/16
3	Perf. top
2	Perf. bottom
.....	Perf. top
.....	Perf. bottom

Casing Cemented .. Size .. No. Ft. .. Date ..

Formation	Color	Hard or Soft	Top	Bottom	Oil, Gas & Coal or Water	Depth Found	Remarks
SURFACE SAND			0	1531			
SHALE			1531	2368			
LIME & SHALE			2368	2539			
SHALE & LIME			2539	2620			
LIME & SHALE			2620	2751			
SHALE & LIME			2751	2915			
LIME & SHALE			2915	3210			
LIME			3210	3539			
LIME & SHALE			3539	4712			
LIME			4712	5368			
LIME & SHALE			5368	5503			
LIME			5503	5555			
LIME & SHALE			5555	6052			
LIME			6052	6277			
LIME & SHALE			6277	6320			
LIME			6320	6450			
TOTAL DEPTH			6450				

DRY & ABANDONED - PLUGGED 2/14/69

THE UNDERSIGNED, LOHMANN-JOHNSON DRILLING CO., INC., HEREBY CERTIFIES THAT THE ABOVE IS A TRUE AND CORRECT LOG OF THE FORMATIONS ENCOUNTERED IN DRILLING THIS WELL IN ACCORDANCE WITH THE DAILY DRILLING REPORTS

LOHMANN-JOHNSON DRILLING CO., INC

By CG. B. Putman, Vice-President

Subscribed and sworn to before me this 21st day of February, 1969

Helen V. Fields
Helen V Fields - Notary Public
My Commission expires
November 5, 1969

