


WELL PLUGGING RECORD

Give All Information Completely
Make Required Affidavit
Mail or Deliver Report to:
Conservation Division
State Corporation Commission
211 No. Broadway
Wichita, Kansas

Meade County, Sec. 21 Twp. 34S Rge. 30W (X) (W)

Location as "NE/CNW/SW" or footage from lines G-SE-NW
Lease Owner Socony Mobil Oil Company, Inc.
Lease Name Staples Estate Well No. 1
Office Address 300 N. Broadway, Wichita, Kansas 67202
Character of Well (completed as Oil, Gas or Dry Hole) Drilled Dry
Date well completed 5-26-65 19
Application for plugging filed 5-27-65 19
Application for plugging approved 5-26-65 19
Plugging commenced 5-26-65 19
Plugging completed 5-26-65 19
Reason for abandonment of well or producing formation Drilled Dry

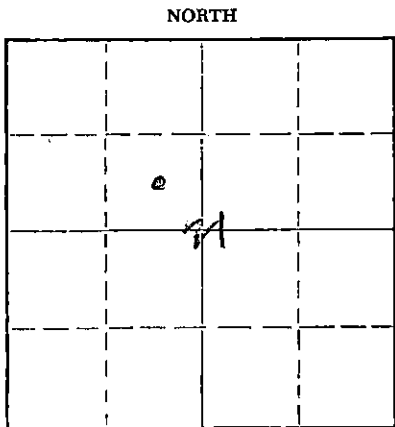

Locate well correctly on above
Section Plat

If a producing well is abandoned, date of last production - 19
Was permission obtained from the Conservation Division or its agents before plugging was commenced? Yes

Name of Conservation Agent who supervised plugging of this well Hugh Scott
Producing formation - Depth to top - Bottom - Total Depth of Well 6600 Feet
Show depth and thickness of all water, oil and gas formations.

OIL, GAS OR WATER RECORDS

CASING RECORD

FORMATION	CONTENT	FROM	TO	SIZE	PUT IN	PULLED OUT
				8 5/8"	1532	None

Describe in detail the manner in which the well was plugged, indicating where the mud fluid was placed and the method or methods used in introducing it into the hole. If cement or other plugs were used, state the character of same and depth placed, from - feet to - feet for each plug set.

Sun cementers pumped 35 sacks cement plug @ 700' in 8 5/8" casing. Set plug @ 45' and cemented to surface with 15 sacks cement. Drilled and abandoned.

1965 JUN 10 1965
STATE CORPORATION COMMISSION
CONSERVATION DIVISION
WICHITA, KANSAS

(If additional description is necessary, use BACK of this sheet)

Name of Plugging Contractor Wakefield Drilling Company
Address 515 Union Center Bldg., Wichita, Kansas

STATE OF Kansas, COUNTY OF Sedgwick, ss.
T. V. Herriage (employee of owner) or (~~owner or operator~~) of the above-described well, being first duly sworn on oath, says: That I have knowledge of the facts, statements, and matters herein contained and the log of the above-described well as filed and that the same are true and correct. So help me God.

(Signature) T. V. Herriage Dist. Acctg. Group Supr.
300 N. Broadway, Wichita, Kansas 67202
(Address)

SUBSCRIBED AND SWORN TO before me this 28th day of May, 1965

My commission expires 7-5-66
[Signature] Notary Public

LEASE: STAPLES ESTATE #1	LOCATION: C SE NW
OWNER: MOBIL OIL COMPANY	SECTION 21-34S-30W
CONT: EARL F. WAKEFIELD	MEADE COUNTY, KANSAS
COMM: 5-4-65	CASING: 8 5/8" Set @ 1532'
COMP: 5-24-65	T.D. @ 6600'

Sand & Clay, Gravel	660
Red Bed & Sand	1410
Shale	1515
Anhydrite	1530
Anhydrite & Shale	1620
Sand, Clay & Shale	1890
Shale & Lime	2140
Lime & Shale	2537
Lime	2708
Lime & Shale	3050
Lime	3189
Lime & Shale	3650
Lime - Shale - Chalk	3774
Lime & Shale	4114
Lime	4161
Shale	4407
Lime & Shale	4662
Lime	4846
Lime & Shale	4890
Lime	5055
Lime & Shale	5182
Lime	5350
Shale - Lime	5368
Lime & Shale	5391
Lime	6276
Lime (Sandy)	6330
Lime	6411
Lime Sand	6424
Lime	6600
R.T.D.	6600

RECEIVED
STATE CORPORATION COMMISSION

JUN 10 1965

CONSERVATION DIVISION
Wichita, Kansas

STATE OF KANSAS)
)
COUNTY OF SEDGWICK) SS

I, FRED S. BARKER, DO HEREBY CERTIFY THAT THE ABOVE IS A TRUE AND CORRECT COPY OF THE DRILLER'S LOG ON THE STAPLES ESTATE #1, LOCATED C SE NW OF SECTION 21-34S-30W, MEADE COUNTY, KANSAS.

EARL F. WAKEFIELD

BY Fred S. Barker
Fred S. Barker

SUBSCRIBED AND SWORN TO BEFORE ME THIS 3RD DAY OF JUNE, 1965.

MY COMMISSION EXPIRES:
JANUARY 25, 1969

Wanda M. Riley
NOTARY PUBLIC