


STATE OF KANSAS  
STATE CORPORATION COMMISSION

Form CP-4

Give All Information Completely  
Make Required Affidavit  
Mail or Deliver Report to:  
Conservation Division  
State Corporation Commission  
P. O. Box 17027  
Wichita, Kansas 67217

WELL PLUGGING RECORD

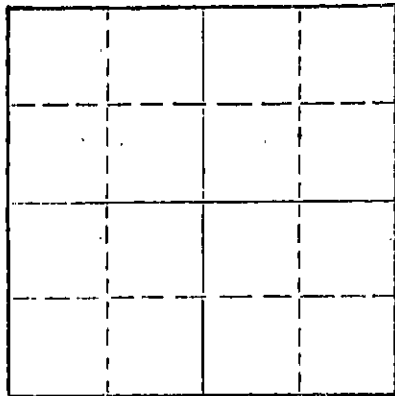

Locate well correctly on above  
Section Plat

Location as "NE/CNW/SW" or footage from lines \_\_\_\_\_  
Lease Owner \_\_\_\_\_  
Lease Name \_\_\_\_\_  
Office Address \_\_\_\_\_  
Character of Well (completed as Oil, Gas or Dry Hole) \_\_\_\_\_  
Date well completed \_\_\_\_\_  
Application for plugging filed \_\_\_\_\_  
Application for plugging approved \_\_\_\_\_  
Plugging commenced \_\_\_\_\_  
Plugging completed \_\_\_\_\_  
Reason for abandonment of well or producing formation \_\_\_\_\_

If a producing well is abandoned, date of last production \_\_\_\_\_  
Was permission obtained from the Conservation Division or its agents before plugging was commenced? \_\_\_\_\_

Name of Conservation Agent who supervised plugging of this well \_\_\_\_\_  
Producing formation \_\_\_\_\_ Depth to top \_\_\_\_\_ Bottom \_\_\_\_\_ Total Depth of Well 6000 Feet  
Show depth and thickness of all water, oil and gas formations.

OIL, GAS OR WATER RECORDS

CASING RECORD

FORMATION	CONTENT	FROM	TO	SIZE	PUT IN	PULLED OUT
	Surface	0	1504'	8-5/8"	1504'	None
	Casing					


Describe in detail the manner in which the well was plugged, indicating where the mud fluid was placed and the method or methods used in introducing it into the hole. If cement or other plugs were used, state the character of same and depth placed, from \_\_\_\_\_ feet to \_\_\_\_\_ feet for each plug set.

Heavy Mud from Total Depth to 1000 Feet,  
35 sax Cement Plug; Heavy Mud to 45 Feet,  
Firm Bridge & 15 sax Cement from 45 Feet  
to 0. Job Completed @ 10:15 P.M. 4/1/74.

RECEIVED  
STATE CORPORATION COMMISSION  
APR 8 - 1974  
CONSERVATION DIVISION  
Wichita, Kansas

(If additional description is necessary, use BACK of this sheet)  
Name of Plugging Contractor \_\_\_\_\_  
Address \_\_\_\_\_

STATE OF KANSAS, COUNTY OF SEDGWICK, ss.  
T. M. McCaul, Jr. of Sage Drilling Co. being first duly sworn on oath, says: That I have knowledge of the facts, statements, and matters herein contained and the log of the above described well as filed and that the same are true and correct. So help me God.

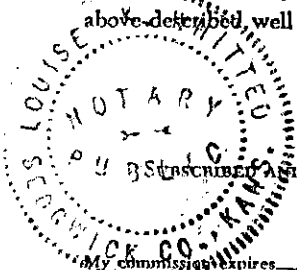

(Signature) \_\_\_\_\_  
500 Bitting Bldg., Wichita, Kansas  
(Address)

Subscribed and Sworn to before me this 3rd day of April, 1974.  
November 26, 1974.  
Louise K. Whitted - Notary Public.

15-119-20161-0000

RECEIVED  
STATE CORPORATION COMMISSION

APR 8 - 1974

CONSERVATION DIVISION  
Wichita, Kansas

DRILLERS LOG

J. S. ADAMS NO. 1

CASING RECORD:	OPERATOR:	Consolidated Products Co.	DESCRIPTION:
8-5/8" @ 1504' w/650 sax cement	CONTRACTOR:	Sage Drilling Co., Inc.	C SW SW Sec. 15-34S-30W Meade County, Kansas.
TOTAL DEPTH: 6000'	COMMENCED:	March 20, 1974	
	COMPLETED:	April 1, 1974	

<u>FORMATION</u>	<u>FROM</u>	<u>TO</u>	<u>REMARKS</u>
Surface Soil & Red Bed	0	163	
Clay, Red Bed	163	973	
Red Bed, Sand & Anhydrite	973	1508	
Clay & Red Bed	1508	2037	
Shale w/Lime Streaks	2037	2487	
Lime & Shale	2487	2544	
Shale & Lime	2544	2660	
Lime & Shale	2660	6000	D&A

I certify that this is a true and correct copy of the above log to the best of my knowledge.

SAGE DRILLING CO., INC.

BY *T. M. McCaul, Jr.*  
T. M. McCaul, Jr.



Subscribed and sworn to before me this 2nd day of April, 1974.

*Louise K. Whitted*  
Louise K. Whitted, Notary Public

My commission expires:  
November 26, 1974.