

15-175-00076-00-01

STATE OF KANSAS
STATE CORPORATION COMMISSION

Form CP-4


WELL PLUGGING RECORD

Give All Information Completely
Make Required Affidavit
Mail or Deliver Report to:
Conservation Division
State Corporation Commission
211 No. Broadway
Wichita, Kansas

Seward County. Sec. 14 Twp. 34S Rge. (E) 31 (W)

Location as "NE/CNW/SW" or footage from lines C-NE-SE
Lease Owner J. M. HUBER CORPORATION
Lease Name Keating Well No. 1
Office Address P O Box 978, Liberal, Kansas
Character of Well (completed as Oil, Gas or Dry Hole) Dry hole
Date well completed October 31, 19 62
Application for plugging filed November 21, 19 62
Application for plugging approved November 23, 19 62
Plugging commenced November 23, 19 62
Plugging completed November 24, 19 62
Reason for abandonment of well or producing formation Dry hole

NORTH

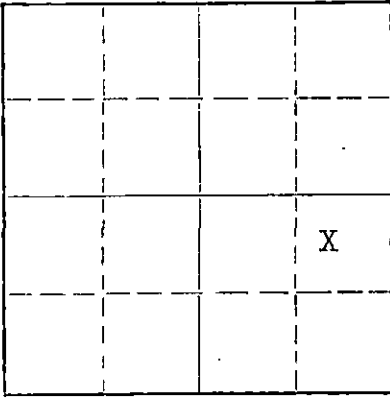

Locate well correctly on above
Section Plat

If a producing well is abandoned, date of last production 19
Was permission obtained from the Conservation Division or its agents before plugging was commenced? Yes

Name of Conservation Agent who supervised plugging of this well Hugh Scott
Producing formation None Depth to top Bottom Total Depth of Well 6,149 Feet
Show depth and thickness of all water, oil and gas formations.

OIL, GAS OR WATER RECORDS

CASING RECORD

FORMATION	CONTENT	FROM	TO	SIZE	PUT IN	PULLED OUT
				13-3/8	628	None
				8-5/8	2553	None
				5-1/2	6149	None

Describe in detail the manner in which the well was plugged, indicating where the mud fluid was placed and the method or methods used in introducing it into the hole. If cement or other plugs were used, state the character of same and depth placed, from feet to feet for each plug set.
Placed 25 sacks plug from 1,718' to 1,640'
Placed 35 sacks plug from 750' to 640'
Placed 15 sacks plug from 45' to Surface
Welded steel cap on top of Surface pipe.

RECEIVED
STATE CORPORATION COMMISSION
JAN 7 1963

Name of Plugging Contractor D A C Well Servicing Company
Address Borger, Texas

STATE OF Kansas, COUNTY OF Seward, ss.
Floyd L. Meade (employee of owner) or (owner or operator) of the above-described well, being first duly sworn on oath, says: That I have knowledge of the facts, statements, and matters herein contained and the log of the above-described well as filed and that the same are true and correct. So help me God.

(Signature) Floyd L. Meade Dist. Engineer
P O Box 978, Liberal, Kansas (Address)

SUBSCRIBED AND SWORN TO before me this 26th day of November, 19 62

My commission expires August 5, 1964
Lydia M. Woods Notary Public.

WELL LOG BUREAU--KANSAS GEOLOGICAL SOCIETY
503 East Murdock, Wichita, Kansas


COPY

Company- LAMSEKAN et al.
Farm- Keating No. 1

SEC. 14 T. 34 R. 31W
C. NE SE

Total Depth. 6150
Comm. 12-3-52 op. 1-3-53
Shot or Treated.
Contractor. Mid-Western Drilling Co.
Issued. 2-14-53

County Seward
KANSAS

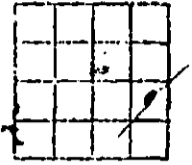

CASING:
8 5/8" 2548' w/ 600 sx cement.
13" 628' w/ cement

Elev. In. 2602
Production. Dry

Figures indicate Bottom of Formations.

sand & clay	490
clay & sand streaks	610
red bed	683
shale & gyp	1195
red bed & shale	1471
shale & shells	2375
shale & lime streaks	2530
lime	2680
lime & shale	2920
lime	2947
lime & shale	3120
lime	3250
lime & shale	4452
lime	4497
lime & shale	4720
lime	4755
lime & shale	5034
lime	5115
lime & shale	5165
lime	5205
lime & shale	5250
lime	5350
lime & shale	5375
sand & shale	5434
shale & lime	5510
lime	5545
lime & shale	5965
lime	5973
lime & chert	6003
lime	6031
lime & shale	6095
lime	6150
Total Depth	

RECEIVED
JAN. 20 1962
CONSERVATION DIVISION

DEC 10 1962

CONSERVATION DIVISION
Wichita, Kansas

TOPS:	SCOUT	SJ
Hollenberg	2437	2427
Herrington	2506	2428
Krider	2532	2526
Heebner		4204
Lansing		4384
Marmaton		5057
Atako		5357
Morrow sand		5590
Morrow shale	5599	
Chester		5719
St. Genevieve	5957	5862