


STATE OF KANSAS
STATE CORPORATION COMMISSION

WELL PLUGGING RECORD

Give All Information Completely
Make Required Affidavit
Mail or Deliver Report to
Conservation Division
State Corporation Comm.
245 North Water
Wichita, KS 67202

Morton County, Sec. 17 Twp. 34S Rge. 43 xR/W
Location as "NE/CNW1SW1/4" or footage from lines
3187' FEL & 3425' FSL

Lease Owner Unitized-Anadarko Production Company
Lease Name INTERSTATE UNIT Well No. 12
Office Address P. O. Box 351, Liberal, Kansas 67901
Character of Well (Completed as Oil, Gas or Dry Hole) _____

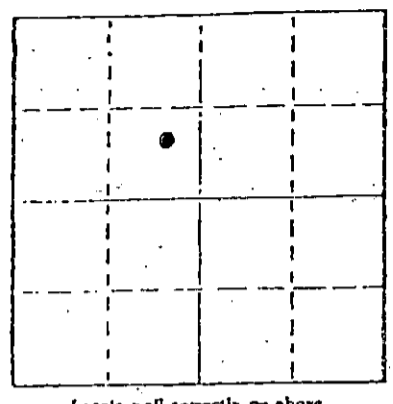

Locate well correctly on above
Section Plat

Oil
Date Well completed April 30 1958
Application for plugging filed October 22 1979
Application for plugging approved October 25 1979
Plugging commenced October 26 1979
Plugging completed October 27 1979

Reason for abandonment of well or producing formation
Casing in bad condition, uneconomical to repair
If a producing well is abandoned, date of last ~~production~~ injection October 1979
Convert to Injection 9/71 October 1979
Was permission obtained from the Conservation Division or
its agents before plugging was commenced? yes

Name of Conservation Agent who supervised plugging of this well Clarence Thomas
Producing formation Purdy Morrow Depth to top 4240 Bottom 4289 Total Depth of Well 4350
Show depth and thickness of all water, oil and gas formations.

OIL, GAS OR WATER RECORDS

CASING RECORD

FORMATION	CONTENT	FROM	TO	SIZE	PUT IN	PULLED OUT
				7"	1242'	None
				4-1/2"	4349'	1730'

Describe in detail the manner in which the well was plugged, indicating where the mud fluid was placed and the method or methods used in introducing it into the hold. If cement or other plugs were used, state the character of same and depth placed, from _____ feet to _____ feet for each plug set.

- Spotted 5 sxs (60') Thixotropic cmt @ 4100'
- 50 sxs common cmt 2600-2400'
- 50 sxs common cmt 1300-1100'
- 25 sxs common cmt 600-500'
- 10 sxs common cmt 40-0'

11-08-79
STATE RECEIVED
NOV 18 1979
STATE CORPORATION COMMISSION
WICHITA, KANSAS

(If additional description is necessary, use BACK of this sheet)

Name of Plugging Contractor Sargent's Casing Pulling Service

STATE OF KANSAS COUNTY OF SEWARD
Paul Campbell (employee of owner) or ~~XXXXXXXXXXXXXXXXXXXX~~

of the above-described well, being first duly sworn on oath, says: That I have knowledge of the facts, statements, and matters herein contained and the log of the above-described well as filed and that the same are true and correct. So help me God.

(Signature) Paul Campbell
P. O. Box 351, Liberal, Kansas 67901
(Address)

SUBSCRIBED AND SWORN TO before me this 7th day of November, 1979

BEVERLY J. WILLIAMS
Seward County, Kansas
My Appt. Exp. _____

My commission expires November 21, 1982

Beverly J. Williams
Notary Public.

DRILLER'S LOG

WELL NAME: Humble #41; COMPANY OPERATING: Panhandle Eastern Pipe Line Co
 ADDRESS of COMPANY: Box 351, Liberal, Kansas

WELL LOCATION: C 1/4 SE 1/4 NW 1/4,
3300 ft. North of South line,
1930 ft. East of West line; Sec. 17, Twp. 34S, Rge. 43W, Horton County, Kansas

DRILLING STARTED April 2, 1958; DRILLING COMPLETED April 17, 1958
 WELL COMPLETED April 30, 1958; WELL CONNECTED _____, 19____

ELEVATION: 3553 ft. Ground Level; CHARACTER OF WELL (Oil, Gas, or Dry Hole) Oil

OIL OR GAS SANDS OR ZONES - PERFORATIONS - ACIDIZING AND FRACTURING INFORMATION					
Name	From	To	No. of Shots	Gallons Used	Kind Used
Morrow "Purdy" Sand	4252'	62'	40		

CASING RECORD

Size	Amount Set	Sacks of Cement	Amount Pulled
7"	1242'	150	0
4 1/2"	439'	100	0

FORMATION RECORD

Formation	Top	Bottom	Formation	Top	Bottom
Surface & sand	0	630	Waubesaes	2550	
Sand, shale & red bed	620	1050	Topeka	2707	
Shale & Anny.	1050	1270	Greenwood Lansing	2707	
Shale & sand	1270	2325	Lawrence	3307	
Shale & shale	2325	4050	Lansing	3170	
Hard lime	4050	4170	Morrow shale	4170	
Shale	4170	4350-10'	Morrow shale	4200	4289

STATE CORPORATION COMMISSION
 DIVISION OF CONSERVATION
 OCT 23 1979
 CONSERVATION DIVISION
 Wichita, Kansas

RESULTS of INITIAL PRODUCTION TEST: _____