

STATE OF KANSAS
STATE CORPORATION COMMISSION


WELL PLUGGING RECORD

Give All Information Completely
Make Required Affidavit
Mail or Deliver Report to:
Conservation Division
State Corporation Commission
800 Bitting Building
Wichita, Kansas

OR
FORMATION PLUGGING RECORD

Strike out upper line
when reporting plug-
ging off formations.

NORTH

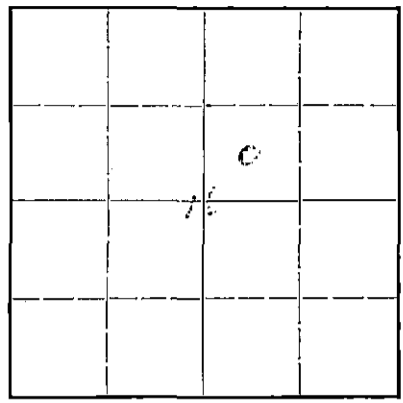

Locate well correctly on above
Section Plat

Morton County Sec. 16 Twp. 34 Rge. (E) 43 (W)
Location as "NE 1/4 NW 1/4 SW 1/4" or footage from lines C. SW. NE
Lease Owner Panhandle Eastern Pipe Line Company
Lease Name Interstate "C" Well No. 03
Office Address 302 North Lincoln, Liberal, Kansas
Character of Well (completed as Oil, Gas or Dry Hole) dry hole
Date well completed September 17, 19 56
Application for plugging filed September 18, 19 56
Application for plugging approved September 18, 19 56
Plugging commenced September 18, 19 56
Plugging completed September 18, 19 56
Reason for abandonment of well or producing formation dry hole

If a producing well is abandoned, date of last production NA 19
Was permission obtained from the Conservation Division or its agents before plugging was com-
menced? Yes

Name of Conservation Agent who supervised plugging of this well M. A. Rives, Box 8, Pratt, Kansas
Producing formation NA Depth to top NA Bottom NA Total Depth of Well 4360 Feet
Show depth and thickness of all water, oil and gas formations.

OIL, GAS OR WATER RECORDS

CASING RECORD

Formation	Content	From	To	Size	Put In	Pulled Out
Upper Morrow	Dry	4284	4292	8-5/8"	1002'	

Describe in detail the manner in which the well was plugged, indicating where the mud fluid was placed and the method or methods used in introducing it into the hold. If cement or other plugs were used, state the character of same and depth placed; from feet to feet for each plug set.

Cement plugs were placed by the pumping displacement method as follows:
25 sacks cement on bottom
25 sacks cement at 995'
8 sacks at surface

The interval between plugs was filled with heavy mud-laden fluid.

(If additional description is necessary, use BACK of this sheet)

Correspondence regarding this well should be addressed to Panhandle Eastern Pipe Line Company
Address Box #351, Liberal, Kansas

STATE OF Kansas, COUNTY OF Seward, ss.

B. J. Delap (employee of owner) or (owner or operator) of the above-described well,
being first duly sworn on oath, says: That I have knowledge of the facts, statements, and matters herein contained and the log of the above-described well as filed and that the same are true and correct. So help me God.

(Signature) B. J. Delap

Box #351, Liberal, Kansas (Address)

SUBSCRIBED AND SWORN to before me this 27th day of September, 1956

My commission expires

Raymond R. Ropey Notary Public.

MY COMMISSION EXPIRES
NOVEMBER 21 1957

PLUGGING
FILE SEC 16 T 34 R 43w
BOOK PAGE 103 LINE 19

WELL NAME: Interstate "C"-03

WELL LOCATION: C of SW NE of Section 16, Township 34, Range 43, being located 3300' east of the West Section Line, and 3300' north of the South Section Line.

COUNTY: Morton STATE: Kansas ELEVATION: 3562.24'

COMPANY: Panhandle Eastern Pipe Line Company

CONTRACTOR: Nye and Snell Drilling Company

ORIGINAL OPEN FLOW:	Dry Hole	DRILLING COMMENCED:	Sept. 1, 1956
DELIVERABILITY AFTER ACID:	Dry Hole	DRILLING COMPLETED:	Sept. 18, 1956
ROCK PRESSURE:	Dry Hole	WELL COMPLETED:	Sept. 18, 1956
SOURCE OF DATA:	Driller's Report	WELL CONNECTED:	Dry Hole

ROTARY LOG:

Description of Formation	Top	Bottom
Sand, Red Bed, Gravel	0'	255'
Red Bed	255'	826'
Red Bed, Anhydrite	826'	959'
Red Bed and Shale	959'	1010'

SET 8-5/8" Surface Casing @ 1010' w/750 sx cmt.

Red Bed and Shale	1010'	1270'
Anhydrite, Shale	1270'	1640'
Shale	1640'	1832'
Shale & Shells	1832'	2292'
Shale & Lime	2292'	2930'
Lime	2930'	3034'
Lime & Shale	3034'	3191'
Lime	3191'	3315'
Lime & Shale	3315'	4043'
Lime	4043'	4130'
Lime & Shale	4130'	4360' TD.

FORMATION TOPS:

Upper Morrow 4284'

PERFORATIONS: None

WELL TREATMENT RECORD: Well was a dry hole and was not treated.

