


STATE OF KANSAS  
STATE CORPORATION COMMISSION

WELL PLUGGING RECORD

Give All Information Completely  
Make Required Affidavit  
Mail or Deliver Report to  
Conservation Division  
State Corporation Comm.  
245 North Water  
Wichita, KS 67202

Morton County, Sec. 11 Twp. 34S Rge. 43 ~~xx~~/W  
Location as "NE/CNW/SW" or footage from lines  
NE NW

Lease Owner Anadarko Production Company  
Lease Name INTERSTATE "S" Well No. 1  
Office Address P. O. Box 351, Liberal, Kansas 67901  
Character of Well (Completed as Oil, Gas or Dry Hole)

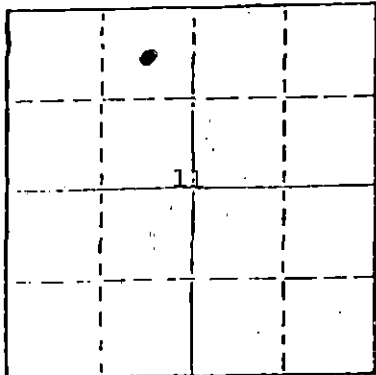

Locate well correctly on above  
Section Plot

DRY HOLE  
Date Well completed 9/16 1981  
Application for plugging filed 10/16 1981  
Application for plugging approved 9/16 verbal 1981  
Plugging commenced 9/16 1981  
Plugging completed 9/16 1981

Reason for abandonment of well or producing formation  
DRY HOLE  
If a producing well is abandoned, date of last production 19

Was permission obtained from the Conservation Division or  
its agents before plugging was commenced? YES

Name of Conservation Agent who supervised plugging of this well Clarence Thomas  
Producing formation \_\_\_\_\_ Depth to top \_\_\_\_\_ Bottom \_\_\_\_\_ Total Depth of Well 5125'  
Show depth and thickness of all water, oil and gas formations.

OIL, GAS OR WATER RECORDS

CASING RECORD

FORMATION	CONTENT	FROM	TO	SIZE	PUT IN	PULLED OUT
				8-5/8"	1270'	-0-

Describe in detail the manner in which the well was plugged, indicating where the mud fluid  
was placed and the method or methods used in introducing it into the hold. If cement or other  
plugs were used, state the character of same and depth placed, from \_\_\_\_\_ feet to  
\_\_\_\_\_ feet for each plug set.

Spotted 50 sxs cmt 1245-1145', pushed rubber plug and bridge to 50', 15 sxs cmt 40-0, 10 sxs  
cmt each in rathole and mousehole.

RECEIVED  
STATE CORPORATION COMMISSION

(If additional description is necessary, use BACK of this sheet)  
Name of Plugging Contractor Johnson Drilling Co., Inc.

CONSERVATION DIVISION  
Wichita, Kansas

STATE OF KANSAS COUNTY OF SEWARD, ss.  
Paul Campbell (employee of owner) or (operator)

of the above-described well, being first duly sworn on oath, says: That I have knowledge of  
the facts, statements, and matters herein contained and the log of the above-described well  
as filed and that the same are true and correct. So help me God

(Signature) Paul Campbell  
P. O. Box 351, Liberal, Kansas 67901

SUBSCRIBED AND SWORN TO before me this 21<sup>st</sup> day of October, 19 81

STATE NOTARY PUBLIC  
BEVERLY J. WILLIAMS  
Seward County, Kansas

(Address)  
Beverly J. Williams  
Notary Public.

My commission expires November 21, 1982