


STATE OF KANSAS
STATE CORPORATION COMMISSION
200 Colorado Derby Bldg.
Wichita, Kansas 67202

Form CP-4
Rev. 12-15-80

WELL PLUGGING RECORD

Give All Information Completely
Make Required Affidavit

COUNTY Morton SEC. 10 TWP. 34S RGE. 43 X/W
Location as in quarters or footage from lines:
C NW/4

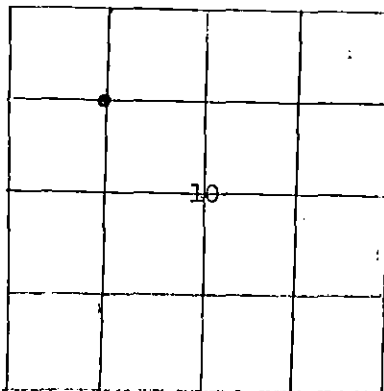

Lease Owner Anadarko Production Company
Lease Name INTERSTATE "I" Well No. 4
Office Address P. O. Box 351, Liberal, Kansas 67901
Character of Well (Completed as Oil, Gas or Dry Hole): DRY HOLE
Date Well Completed 12/14/81
Application for plugging filed 12/7/81
Plugging commenced 12/10/81
Plugging completed 12/14/81
Reason for abandonment of well or producing formation No Gas

Locate Well
correctly on above
Section Platt.

Was permission obtained from the Conservation Division or it's
Agent's before plugging was commenced? Yes

Name of Conservation Agent who supervised plugging of this well Clarence Thomas
Producing formation Red Cave Depth to top 1329 bottom 1341 T.D. 1411
Show depth and thickness of all water, oil and gas formations.

OIL, GAS OR WATER RECORDS

Casing Record

Formation	Content	From	To	Size	Put in	Pulled Out
Surface	583	-0-	583	8-5/8"	583'	-0-
Production	1410'	-0-	1410'	4-1/2"	1410'	-0-

Describe in detail the manner in which the well was plugged, indicating where the mud
fluid was placed and the method or methods used in introducing it into the hold. If cement
or other plugs were used, state the character of same and depth placed, from _____ feet
to _____ feet for each plug set.

Cmt w/125 sxs common + 3% CaCl, squeeze perf 1329-41, MP 500#, 4-1/2" casing filled to
surface w/cmt, cut off 4-1/2" & 8-5/8" casing 4' below GL, weld steel plate on 8-5/8.

(If additional description is necessary, use BACK of this sheet)

Name of Plugging Contractor Sargents Casing Pulling Service

STATE OF KANSAS COUNTY OF SEWARD, ss.
Paul Campbell (employee of owner) or ~~owner~~ of the
above-described well, being first duly sworn on oath, says: That I have knowledge of the
facts, statements, and matters herein contained and the log of the above-described well as
filed and that the same are true and correct. So help me God.

(Signature) Paul Campbell
P. O. Box 351, Liberal, Kansas 67901
(Address)

SUBSCRIBED AND SWORN TO before me this 16th day of March, 1982

BEVERLY J. WILLIAMS
Seward County, Kansas
My Comm. expires November 21, 1982

My Commission expires November 21, 1982

RECEIVED
STATE CORPORATION COMMISSION
Notary Public
MAR 23 1982