


STATE OF KANSAS
STATE CORPORATION COMMISSION

Form CP-4

Give All Information Completely
Make Required Affidavit
Mail or Deliver Report to:
Conservation Division
State Corporation Commission
212 No. Market
Wichita, Kansas

WELL PLUGGING RECORD

NORTH

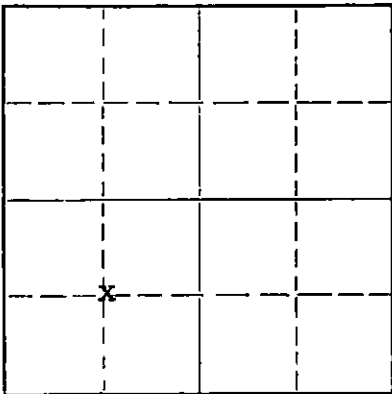

Locate well correctly on above
Section Plat

Morton

County. Sec. 10 Twp. 34S Rge. 43W (E) (W)

Location as "NE/CNW/SW" or footage from lines 1250' FSL, 1390' FWL

Lease Owner. J. M. Huber Corporation

Lease Name. Austin

Well No. #2 (RC)

Office Address P. O. Box 911, Amarillo, Texas

Character of Well (completed as Oil, Gas or Dry Hole) Gas

Date well completed May 1 1966

Application for plugging filed December 15 1969

Application for plugging approved December 18 1969

Plugging commenced December 12 1969

Plugging completed December 12 1969

Reason for abandonment of well or producing formation Unprofitable

If a producing well is abandoned, date of last production Shut-in 19

Was permission obtained from the Conservation Division or its agents before plugging was commenced? Yes

Name of Conservation Agent who supervised plugging of this well Mr. E. Eves

Producing formation Red Cave Depth to top 1297' Bottom 1304' Total Depth of Well 1370' Feet

Show depth and thickness of all water, oil and gas formations.

OIL, GAS OR WATER RECORDS

CASING RECORD

| FORMATION | CONTENT | FROM | TO | SIZE | STATE | PULLED OUT |
|-----------|-----------|------|------|-------|-------|------------|
| Red Cave | Sandstone | 1297 | 1304 | 4-1/2 | 1367 | 0- |
| | | | | | | |
| | | | | | | |
| | | | | | | |
| | | | | | | |
| | | | | | | |
| | | | | | | |
| | | | | | | |

Describe in detail the manner in which the well was plugged, indicating where the mud fluid was placed and the method or methods used in introducing it into the hole. If cement or other plugs were used, state the character of same and depth placed, from feet to feet for each plug set.

Spotted 15 sacks cement 1328'-1148', mud laden fluid 1148'-600',
15 sacks cement 600'-420', mud laden fluid 420'-65', 5 sacks
cement 65'-5'. Cut off & capped. No pipe recovery.

RECEIVED
STATE CORPORATION COMMISSION
DEC 24 1969
CONSERVATION DIVISION
Wichita, Kansas

Name of Plugging Contractor Daco Lease & Well Service
Address 1700 S. Main, Borger, Texas 79007

(If additional description is necessary, use BACK of this sheet)

STATE OF Texas, COUNTY OF Potter, ss.

Bob Conley (employee of owner) or (owner or operator) of the above-described well, being first duly sworn on oath, says: That I have knowledge of the facts, statements, and matters herein contained and the log of the above-described well as filed and that the same are true and correct. So help me God.

(Signature)

P.O. Box 911, Amarillo, Texas

(Address)

SUBSCRIBED AND SWORN TO before me this 29th day of December, 1969

My commission expires

June 1, 1971

Notary Public.

RECEIVED
STATE CORPORATION COMMISSION

FEB 4 1970

CONSERVATION DIVISION
Wichita, Kansas

Austin #2 RC
Section 10-34S-43W
Morton County, Kansas

Driller's Log

| <u>Depth</u> | <u>Formation</u> |
|--------------|-------------------|
| 0-744' | Sand & Shale |
| 744'-850' | Shale & Anhydrite |
| 850'-1260' | Sand & Shale |
| 1260'-1346' | Sand |
| 1346'-1370' | Shale |
| T.D. 1370' | |

Certificate:

I hereby certify the foregoing statements are true and correct to the best of my knowledge and belief.

Bob Conley
Bob Conley

Title: District Production Clerk

Subscribed and sworn to before me, a Notary Public, this 3rd day of February 1970.

Sharon E. Dowell
Notary Public

My Commission Expires
June 1, 1971