


STATE OF KANSAS
STATE CORPORATION COMMISSION

Form CP-4

Give All Information Completely
Make Required Affidavit
Mail or Deliver Report to:
Conservation Division
State Corporation Commission
P. O. Box 17027
Wichita, Kansas 67217
NORTH

WELL PLUGGING RECORD

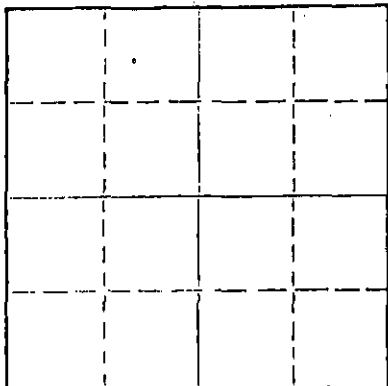

Locate well correctly on above
Section Plat

Sumner County, Sec. 3 Twp. 35 Rge. 1W (E) W (W)
Location as "NE/CNWxSWx" or footage from lines. SE NE NE
Lease Owner EL DORADO SUPPLY COMPANY
Lease Name Dawkins Well No. 1
Office Address 764 Oil Hill Road, El Dorado, KS 67042
Character of Well (completed as Oil, Gas or Dry Hole) Oil
Date well completed 1974
Application for plugging filed July 12 1974
Application for plugging approved July 12 1974
Plugging commenced July 17 1974
Plugging completed July 22 1974
Reason for abandonment of well or producing formation Non-Commercial

If a producing well is abandoned, date of last production 1974
Was permission obtained from the Conservation Division or its agents before plugging was commenced? Yes

Name of Conservation Agent who supervised plugging of this well Ted Dewey, Box 336, Augusta, KS 67010
Producing formation Depth to top Bottom Total Depth of Well 4223' Feet
Show depth and thickness of all water, oil and gas formations.

OIL, GAS OR WATER RECORDS

CASING RECORD

FORMATION	CONTENT	FROM	TO	SIZE	PUT IN	PULLED OUT
				8 5/8"	527'	0
				5 1/2"	4217	1007'

Describe in detail the manner in which the well was plugged, indicating where the mud fluid was placed and the method or methods used in introducing it into the hole. If cement or other plugs were used, state the character of same and depth placed, from 4223' feet to 4183 feet for each plug set.

July 17 - Dumped 5 sacks cement from 4223' to 4183'.


July 22 - Made rock bridge from 275' to 260'. Dumped 4 yds. ready mix from 260' to top.

RECEIVED
STATE CORPORATION COMMISSION
AUG 15 1974
CONSERVATION DIVISION
Wichita, Kansas

(If additional description is necessary, use BACK of this sheet)
Name of Plugging Contractor EL DORADO SUPPLY COMPANY
Address 764 Oil Hill Road, El Dorado, KS 67042

STATE OF Kansas, COUNTY OF Sumner, ss.
Orval L. North


(Signature) Orval L. North
764 Oil Hill Road, El Dorado, KS 67042
(Address)

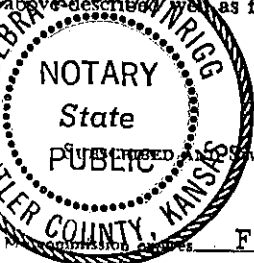

Subscribed and sworn to before me this 13th day of August, 1974
February 12, 1978
Debra A. Brownrigg
Notary Public.

15-191-19,094-0000

COPY

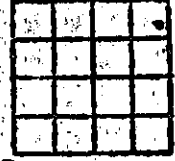WELL LOG BUREAU—KANSAS GEOLOGICAL SOCIETY
503 East Murdock, Wichita, KansasCompany HERNDON DRILLING CO.
Farm Dawkins No. 1SEC. 3 T. 35 R. 1W
SE NE NETotal Depth, 4223
Comm. 7-25-54 Comp. 8-11-54
Shot or Treated.
Contractor, Herndon Drilling Co.
Issued, 10-9-54County Sumner
KANSASCASING:
8 5/8 @ 527' w/ 300 sx cmt.
5 1/2 @ 4217' w/ 300 sx cmt.

Elevation, 1106 RB

Production Pot. 281 BOPD

Figures Indicate Bottom of Formations.

surface hole	533
lime & shale	2725
shale, lime & sand	2933
shale & lime	3150
sand & shale	3205
sand, shale & lime	3325
lime & shale	3373
lime	3445
shale & sand	3505
lime & shale	3879
chert & lime	3990
lime	4145
shale	4218
sand	4223
Total Depth	

TOPS:	
Layton sand	3169
Mississippi chat	3878
Simpson sand	4217

No new hole

RECEIVED
STATE CORPORATION COMMISSION
JUL 12 1954
CONSERVATION DIVISION
Wichita, Kansas