


STATE OF KANSAS
STATE CORPORATION COMMISSION

WELL PLUGGING RECORD

Give All Information Completely
Make Required Affidavit
Mail or Deliver Report to
Conservation Division
State Corporation Comm.
245 North Water
Wichita, KS 67202

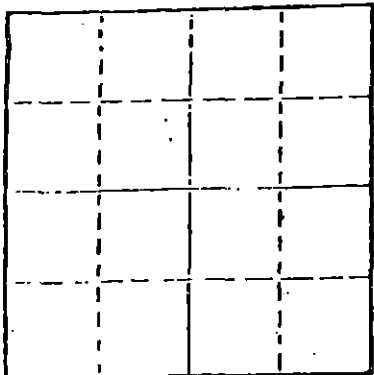

Locate well correctly on above
Section Plot

Sumner County. Sec. 2 Twp. 358 Rge. 1W E/W
Location as "NE/CNW/SW" or footage from lines NW-SW-NW

Lease Owner W. S. Kirkman
Lease Name Wegman Well No. 1
Office Address P.O. Box 18611
Character of Well (Completed as Oil, Gas or Dry Hole) Dry Hole

Date Well completed 10/4 1979
Application for plugging filed 10/4 1979
Application for plugging approved 10/4 1979
Plugging commenced 10/4 1979
Plugging completed 10/4 1979
Reason for abandonment of well or producing formation Dry Hole

If a producing well is abandoned, date of last production 19

Was permission obtained from the Conservation Division or its agents before plugging was commenced? yes

Name of Conservation Agent who supervised plugging of this well Carl Bennett
Producing formation _____ Depth to top _____ Bottom _____ Total Depth of Well 245'
Show depth and thickness of all water, oil and gas formations.

OIL, GAS OR WATER RECORDS

CASING RECORD

FORMATION	CONTENT	FROM	TO	SIZE	PUT IN	PULLED OUT
				7"	270'	None
					Pumped	

Describe in detail the manner in which the well was plugged, indicating where the mud fluid was placed and the method or methods used in introducing it into the hold. If cement or other plugs were used, state the character of same and depth placed, from _____ feet to _____ feet for each plug set.

mudded up to 300' 1st plug 20 cu cement
40' 2nd plug 8 cu cement

RECEIVED
STATE CORPORATION COMMISSION
10-15-79
OCT 15 1979


(If additional description is necessary, use BACK of this sheet)

Name of Plugging Contractor B. N. Dilling Division Benson, Mineral Drilling, Inc.

STATE OF Kansas COUNTY OF DeKalb, ss. Contractor
Betty E. Plib (employee of owner) or (owner or operator)
of the above-described well, being first duly sworn on oath, says: That I have knowledge of the facts, statements, and matters herein contained and the log of the above-described well as filed and that the same are true and correct. So help me God.

(Signature) Betty E. Plib
570 East Side Dr. Centur - Wichita, KS (Address) 67207

Romana R. Moore
Notary Public.

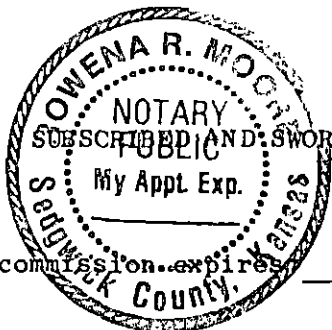

My commission expires _____

July 12, 1983

15-191-20960-0000

KANSAS


WELL COMPLETION REPORT AND
DRILLER'S LOG

API No. 15 — County — Number —

S. 2 T. 35S R. 1W E
W

Loc. —

County Sumner

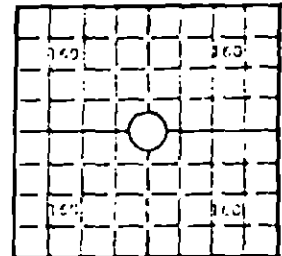640 Acres
N

Locate well correctly

Elev.: Gr. —

DF — KB —

Operator

W. L. Kirkman

Address

P.O. Box 18611 Wichita, Kansas 67202

Well No.

A-1

Lease Name

Yearout

Footage Location

feet from (N) (S) line

feet from (E) (W) line

Principal Contractor

B & N Drilling

Geologist

Spud Date

9/27/79

Date Completed

10/4/79

Total Depth

2451

P.B.T.D.

Directional Deviation

Oil and/or Gas Purchaser

CASING RECORD

Report of all strings set — surface, intermediate, production, etc.

Purpose of string	Size hole drilled	Size casing set (in O.D.)	Weight lbs/ft.	Setting depth	Type cement	Sacks	Type and percent additives
SURFACE	9 7/8	7"		274.35			
PRODUCTION	6 1/2	Plugged					

LINER RECORD

PERFORATION RECORD

Top, ft.	Bottom, ft.	Sacks cement	Shots per ft.	Size & type	Depth interval

TUBING RECORD

Size	Setting depth	Packer set at			

ACID, FRACTURE, SHOT, CEMENT SQUEEZE RECORD

Amount and kind of material used	Depth interval treated

INITIAL PRODUCTION

OCT 15 1979

Date of first production		Producing method (flowing, pumping, gas lift, etc.)		CONSERVATION DIVISION Winchita, Kansas	
RATE OF PRODUCTION PER 24 HOURS	Oil	Gas	Water	Gas-oil ratio	
	bbls.	MCF	bbls.	CFPB	
Disposition of gas (vented, used on lease or sold)			Producing interval(s)		

INSTRUCTIONS: As provided in KCC Rule 82-2-125, within 90 days after completion of a well, one completed copy of this Driller's Log shall be transmitted to the State Geological Survey of Kansas, 4150 Monroe Street, Wichita, Kansas 67209. Copies of this form are available from the Conservation Division, State Corporation Commission, 10. Water, Wichita, Kansas 67202. Phone AC 316-527 7206. If confidential custody is desired, please note Rule 82-2-125. Driller's Logs will be on file in the Oil and Gas Division, State Geological Survey, Kansas, Lawrence, Kansas 66044.

Operator <u>W. L. Kirkman</u>		DESIGNATE TYPE OF COMP.: OIL, GAS, DRY HOLE, SWDW, ETC.:
Well No. <u>A-1</u>	Lease Name <u>Yearout</u>	
S <u>2</u> T <u>35S</u> R <u>1W</u> ^E _W		

WELL LOG

Show all important zones of porosity and contents thereof; cased intervals, and all drill-stem tests, including depth interval tested, cushion used, time tool open, flowing and shut-in pressures, and recoveries.

SHOW GEOLOGICAL MARKERS, LOGS RUN, OR OTHER DESCRIPTIVE INFORMATION.

FORMATION DESCRIPTION, CONTENTS, ETC.	TOP	BOTTOM	NAME	DEPTH
soil	0	6		
clay	6	12		
shale	12	50		
red rock	50	54		
shale	54	234		
lime	234	236		
shale	236	253		
lime	253	261		
shale	261	273		
lime	273	300		
sand/lime	300	329		
shale/lime	329	679		
sand/shale	679	727		
shale /lime	727	773		
lime	773	785		
shale/lime	785	795		
lime	795	831		
shale	831	876		
lime/shale	876	1265		
sandy shale	1265	1307		
shale/lime	1307	1310		
lime	1310	1313		
shale/lime	1313	1325		
sandy shale	1325	1359		
shale/lime	1359	1429		
sand/shale	1429	1522		
lime	1522	1524		
sand/shale	1524	1586		
sand/lime/shale	1586	1886		
shale	1886	1899		
shale/lime	1899	2110		
lime	2110	2136		
shale/lime	2136	2150		
lime	2150	2197		
shale/sand	2197	2451		

RECEIVED
STATE CORPORATE COMMISSION

OCT 15 1979

CONSERVATION DIVISION
Wichita, Kansas

USE ADDITIONAL SHEETS, IF NECESSARY, TO COMPLETE WELL RECORD.

Date Received	
	Signature
	Title
	Date