


WELL PLUGGING RECORD

See All Information Completely  
like Required Affidavit  
or Deliver Report to:  
Conservation Division  
State Corporation Commission  
P. O. Box 17027  
Wichita, Kansas 67217  
NORTH

Clark County, Sec. 1 Twp. 35 S Rge. 22W (E) (W)  
C SW  
Location as "NE CNVRSW" or footage from lines \_\_\_\_\_  
Lease Owner H. & M Oil Producers, Inc.  
Lease Name Tuttle 7-1 Well No. 7-1  
Office Address 715 Midland Savings Building  
Character of Well (completed as Oil, Gas or Dry Hole) Dry Hole  
Date well completed Plugged 6-1-77 19\_\_  
Application for plugging filed Attached 19\_\_  
Application for plugging approved \_\_\_\_\_ 19\_\_  
Plugging commenced 6-1-77 19\_\_  
Plugging completed 6-1-77 19\_\_  
Reason for abandonment of well or producing formation Dry Hole  
If a producing well is abandoned, date of last production \_\_\_\_\_ 19\_\_  
Was permission obtained from the Conservation Division or its agents before plugging was commenced? Yes, By Telephone

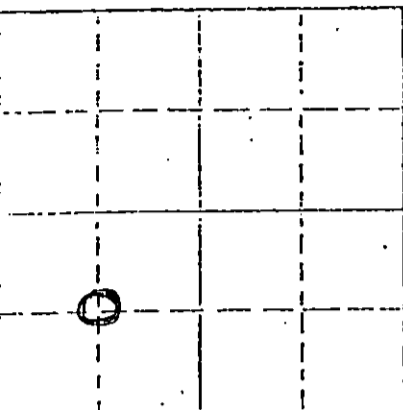

Locate well correctly on above Section Plat.

Name of Conservation Agent who supervised plugging of this well \_\_\_\_\_  
Producing formation None Depth to top \_\_\_\_\_ Bottom \_\_\_\_\_ Total Depth of Well \_\_\_\_\_ Feet  
Show depth and thickness of all water, oil and gas formations.

OIL, GAS OR WATER RECORDS

CASING RECORD

FORMATION	CONTENT	FROM	TO	SIZE	PUT IN	PULLED OUT

Describe in detail the manner in which the well was plugged, indicating where the mud fluid was placed and the method or methods used introducing it into the hole. If cement or other plugs were used, state the character of same and depth placed, from \_\_\_\_\_ feet to \_\_\_\_\_ feet for each plug set.

- 30 SXS. Plug @ 600'
- 20 SXS. Plug @ 40'
- 5 SXS. In Rat Hole
- 5 SXS. In Mouse Hole

RECEIVED  
STATE OF KANSAS  
6-13-77  
JUN 15 1977  
CONSERVATION DIVISION  
WICHITA, KANSAS

Name of Plugging Contractor Thomas Drilling Co. (if additional description is necessary, use BACK of this sheet)  
Address Box 400 Duncan, Oklahoma 73555

STATE OF Oklahoma COUNTY OF Stephens ss.  
John Voss (Signature) (employee of owner) or (owner or operator) of the above-described well, being first duly sworn on oath, says: That I have knowledge of the facts, statements, and matters herein contained and the log of the above-described well as filed and that the same are true and correct. So help me God.  
(Signature) \_\_\_\_\_

SUBSCRIBED AND SWORN TO before me this 8th day of June, 1977  
My Commission Expires: 3-24-79  
Leopoldine Benteley Notary Public.

WELL LOG

COMPANY H & M Oil Producers, Inc. SEC. 1 T 35S R 22W  
 FARM Tuttle NO. 7-1 LOC. cSW $\frac{1}{4}$  (1320' fr WL & 1320' fr SL)  
 TOTAL DEPTH 5743 SLM COUNTY Clark, Kansas  
 COMMENCED 5/18/77 ELEVATION 1951 Ground  
 COMPLETED 5/31/77 1958 Kelly Bushing

SURFACE CASING 16" conductor cemented @ 60'  
8 5/8" casing cemented @ 587'

PLUGGED AND ABANDONED 6/1/77

RECORDED & INDEXED  
JUL 18 1977

FORMATION AS SHOWN BY DRILLING REPORT

- 0 - 252' Sand & Shale
- 2217' Red Bed & Shale
- 3055' Shale
- 3960' Shale & Lime
- 4272' Lime & Shale
- 5445' Shale & Lime
- 5640' Lime & Shale
- 5743' Sand

State of COLORADO )  
County of DENVER ) ss

I, G. W. Speer of H & M Oil Producers, Inc.  
upon oath state the above and foregoing is a true and correct copy of the log  
of the #7-1 Tuttle well.

G. W. Speer

Subscribed and sworn to me before this 14th day of June 1977.

My Commission Expires: July 30, 1978

Marlene Gollhofer  
NOTARY REPUBLIC  
Marlene Gollhofer