


STATE OF KANSAS
STATE CORPORATION COMMISSION

Form CP 1

File All Information Completely
Make Required Affidavit
Mail or Deliver Report to
Conservation Division
State Corporation Commission

WELL PLUGGING RECORD

P. O. Box 17027
Wichita, Kansas 67217

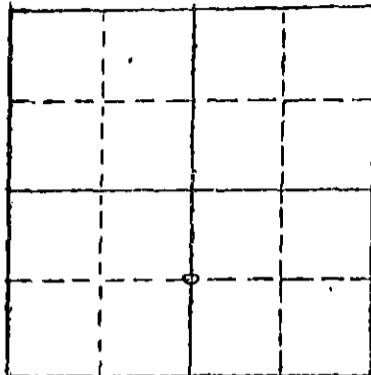

Clark County, Sec. 12 Twp. 35S Rge. 21 (E) W (W)
Location at "NE/CNWS/SW" or footage from line 200' W C. S. 1/2
Lease Owner Kennedy & Mitchell, Inc.
Lessee Name Tuttle Well No. 12-116
Office Address P.O. Box 1578, Liberal, Kansas 67901
Character of Well (completed as Oil, Gas or Dry Hole) dry hole
Date well completed 11-13 19 77
Application for plugging filed _____ 19 _____
Application for plugging approved 11-13 (verbal) 19 77
Plugging commenced 11-14 19 77
Plugging completed 11-14 19 77
Reason for abandonment of well or producing formation dry
If a producing well is abandoned, date of last production _____ 19 _____
Was permission obtained from the Conservation Division or its agents before plugging was commenced? Yes

Name of Conservation Agent who supervised plugging of this well Leo Massey, Hays, Kansas
Producing formation _____ Depth to top _____ Bottom _____ Total Depth of Well 6000 Feet
Show depth and thickness of all water, oil and gas formations.

OIL, GAS OR WATER RECORDS

CASING RECORD

FORMATION	CONTENT	FROM	TO	SIZE	PUT IN	PULLED OUT
				8 5/8	677	None

Describe in detail the manner in which the well was plugged, indicating where the mud fluid was placed and the method or methods used in introducing it into the hole. If cement or other plugs were used, state the character of same and depth placed, from _____ feet to _____ feet for each plug set.

Plugged well as follows: pumped cement - 35 sacks from 5540-5640' -
50 sacks from 627-727'
25 sacks from 250-300'
10 sacks from 10-33'

completed @ 3:00 AM, 11-14-77

RECEIVED
STATE CORPORATION COMMISSION

NOV 15 1977

CONSERVATION DIVISION
Wichita, Kansas

Name of Plugging Contractor Dowell (If additional description is necessary, use BACK of this sheet)
Address Woodward, Oklahoma

STATE OF Kansas COUNTY OF Seward ss.

Janice Heckman (employee of owner) or (owner or operator) of the above-described well, being first duly sworn on oath, says: That I have knowledge of the facts, statements, and matters herein contained and the log of the above-described well as filed and that the same are true and correct. So help me God. o

(Signature) Janice Heckman Agent

P.O. Box 1578, Liberal, Ks. 67901 (Address)

Subscribed and Sworn to before me this 14th day of November 19 77

RHENDA J. VAN METER
Seward County, Ks.
My Appl. Exp. Feb. 12, 1980

Rhenda J. Van Meter
Notary Public.

DRILLERS LOG

TUTTLE NO. 12-116

CASING RECORD:	OPERATOR: Kennedy & Mitchell, Inc.	DESCRIPTION:
8-5/8" set @ 677' w/400 sax cement	CONTRACTOR: Sage Drilling Co., Inc.	C S/2 Sec. 12-35S-21W Clark County, Kansas.
TOTAL DEPTH: 6000'	COMMENCED: November 2, 1977	
	COMPLETED: November 14, 1977	

<u>FORMATION</u>	<u>FROM</u>	<u>TO</u>	<u>REMARKS</u>
Red Bed	0	680	
Shale & Red Bed	680	1670	
Shale & Anhydrite	1670	2001	
Lime & Shale	2001	2750	
Shale & Lime	2750	2990	
Lime & Shale	2990	4157	
Shale & Lime	4157	4407	
Lime & Shale	4407	5876	
Shale & Lime	5876	5962	
Lime & Shale	5962	6000	Logged Hole; D&A

I certify that this is a true and correct copy of the log on the above captioned well to the best of my knowledge.

SAGE DRILLING CO., INC.

By *Tom M. Conley*



Subscribed and sworn to before me this 18th day of November, 1977.

Louise K. Whitted
Louise K. Whitted, Notary Public

My commission expires:
November 26, 1978.