

STATE OF KANSAS  
STATE CORPORATION COMMISSION

Give All Information Completely  
Make Required Affidavit  
Mail or Deliver Report to:  
Conservation Division  
State Corporation Commission  
211 No. Broadway  
Wichita, Kansas

WELL PLUGGING RECORD

Clark County, Sec. 8 Twp. 35S Rge. (#) 21 (W)

Location as "NE/CNW/SW" or footage from lines Approx. 200' NE of C of NW SE

Lease Owner Graham-Michaelis Drilling Company

Lease Name Tuttle Well No. 1-8

Office Address 211 North Broadway, Wichita, Kansas 67202

Character of Well (completed as Oil, Gas or Dry Hole) DRY HOLE

Date well completed April 18, 19 65

Application for plugging filed (verbal) April 18, 19 65

Application for plugging approved (verbal) April 18, 19 65


Plugging commenced April 18, 19 65

Plugging completed April 18, 19 65

Reason for abandonment of well or producing formation Non-commercial

If a producing well is abandoned, date of last production ----- 19

Was permission obtained from the Conservation Division or its agents before plugging was commenced? yes

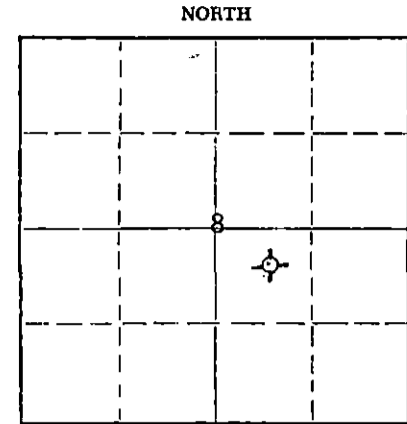

Locate well correctly on above Section Plat

Name of Conservation Agent who supervised plugging of this well Hugh Scott, Box F, Sublette, Kansas

Producing formation none Depth to top -- Bottom -- Total Depth of Well 4590 Feet

Show depth and thickness of all water, oil and gas formations.

OIL, GAS OR WATER RECORDS

CASING RECORD

FORMATION	CONTENT	FROM	TO	SIZE	PUT IN	PULLED OUT
NONE				8 5/8"	608'	none

Describe in detail the manner in which the well was plugged, indicating where the mud fluid was placed and the method or methods used in introducing it into the hole. If cement or other plugs were used, state the character of same and depth placed, from feet to feet for each plug set.

Hole was filled with heavy drilling mud and 35 sacks cement dumped at 608'.

Hole was filled with heavy drilling mud and 15 sacks cement dumped at 45'.

2 sacks cement in rat hole, cement plug at top of surface casing.

RECEIVED  
STATE CORPORATION COMMISSION

APR 26 1965  
4-26-65

CONSERVATION DIVISION  
Wichita, Kansas

(If additional description is necessary, use BACK of this sheet)

Name of Plugging Contractor Graham-Michaelis Drilling Company  
Address 211 North Broadway, Wichita, Kansas 67202


STATE OF Kansas, COUNTY OF Sedgwick, ss.  
John L. James (employee of owner) of the above-described well, being first duly sworn on oath, says: That I have knowledge of the facts, statements, and matters herein contained and the log of the above-described well as filed and that the same are true and correct. So help me God.

(Signature) John L. James - Geologist  
211 North Broadway, Wichita, Kansas 67202  
(Address)

SUBSCRIBED AND SWORN TO before me this 23rd day of April, 19 65

My commission expires December 12, 1966

Evelyn B. Evans Notary Public

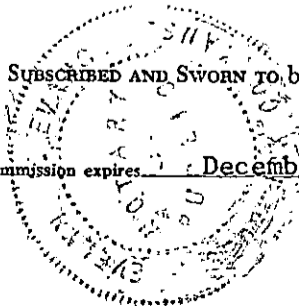

TUTTLE #1-8

WELL RECORD:

LOCATION:	200' NE of C NW SE Section 8-35S-21W Clark County, Kansas	Commenced: 4-10-65 Completed: 4-18-65 (Rotary)
-----------	--	--

CONTRACTOR: Graham-Michaelis Drilling, Inc.  
Liberal Division  
P. O. Box 1294  
Liberal, Kansas

CASING RECORD: 20 Joints 8-5/8" Casing  
Cemented w/200 sx Common 2% cc  
followed w/60 sx Common

	<u>LOG</u>	
Sand & Red Bed	0 - 609	
Red Bed	609 - 1063	
Red Bed & Shale	1063 - 2076	
Lime & Shale	2076 - 4333	
Shale	4333 - 4572	
Lime & Shale	4572 - 4590	<u>4590' - Total Rotary Depth</u>

The undersigned, Graham-Michaelis Drilling, Inc., Liberal Division, certifies that the above log is a true and correct copy of the formations encountered in drilling the above mentioned well, as taken from the Daily Drilling Report.

GRAHAM-MICHAELIS DRILLING, INC.  
LIBERAL DIVISION

By H. R. Michaelis  
H. R. Michaelis

**RECEIVED**  
STATE CORPORATION COMMISSION  
APR 26 1965  
CONSERVATION DIVISION  
Wichita, Kansas