


Give All Information Completely
Make Required Affidavit
Mail or Deliver Report to:
Conservation Division
State Corporation Commission
212 No. Market
Wichita, Kansas

WELL PLUGGING RECORD

Clark County, Sec. 4 Twp. 35 Rge. 21 (E) (W) X
Location as "NE/CNWxSWx" or footage from lines SE NW
Lease Owner Davidor & Davidor, INC.
Lease Name Tuttle Well No. B1
Office Address Oklahoma City, Oklahoma
Character of Well (completed as Oil, Gas or Dry Hole) INITIALLY GAS, THEN OIL
Date well completed JANUARY 25, 1964
Application for plugging filed DECEMBER 9, 1966
Application for plugging approved DECEMBER 12, 1966
Plugging commenced 12/12/66
Plugging completed 12/16/66
Reason for abandonment of well or producing formation depleted

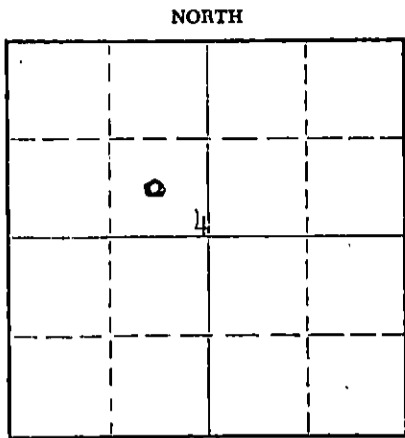

Locate well correctly on above Section Plat

If a producing well is abandoned, date of last production NOVEMBER 7, 1966
Was permission obtained from the Conservation Division or its agents before plugging was commenced? yes

Name of Conservation Agent who supervised plugging of this well Ed Eves
Producing formation MORROW Depth to top 5644 Bottom 5648 Total Depth of Well 5690 Feet
Show depth and thickness of all water, oil and gas formations.


OIL, GAS OR WATER RECORDS

CASING RECORD

FORMATION	CONTENT	FROM	TO	SIZE	PUT IN	PULLED OUT
SANDS	FRESH WATER			8 5/8	658	none
MORROW SAND	GAS & OIL	5644	5648	4 1/2	5689	2038

Describe in detail the manner in which the well was plugged, indicating where the mud fluid was placed and the method or methods used in introducing it into the hole. If cement or other plugs were used, state the character of same and depth placed, from _____ feet to _____ feet for each plug set.

Raised mast, checked bottom. Ran 40 gals. sand. Cleaned cellar. Open gate on surface pipe, had pressure on head. Ran fluid down hole, checked snad, top sand was 5640. Dumped 5 sacks cement, top cement 5587. Had welder hcut off bolts on gas head and weld on 4 1/2 slip on collar. Took gas head off. Put control head on. Rigged up on 4 1/2, had 24" tension. Shot pipe at 5114, 5024, 4918. Work pipe to 35" tension, let pipe set on tension. Shot pipe at 3482, worked pipe, no gain. Shot pipe at 3222, no gain. Shot pipe at 3026 Worked pipe loose, pulled 30 joints. Pulled 63 joints of 4 1/2, cleared floor. Bailed hole to 600', plug well from TD to 5587, sanded 5 sacks cement, 5587 to 600', mud 600' to ~~500~~ 500', 30 sacks cement, 500 to 40', mud 40' to 30' rock, 30 to 0, 10 sacks cement. Tallied pipe.

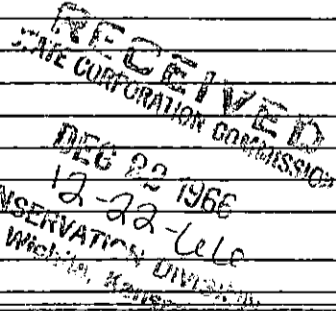

(If additional description is necessary, use BACK of this sheet)
Name of Plugging Contractor KNIGHT CASING PULLING COMPANY
Address Chase, Kansas

STATE OF Kansas COUNTY OF Rice, ss.
Noel J. Knight (employee of owner) or (owner or operator) of the above-described well, being first duly sworn on oath, says: That I have knowledge of the facts, statements, and matters herein contained and the log of the above-described well as filed and that the same are true and correct. So help me God.

(Signature) Noel J. Knight
Chase, Kansas (Address)

SUBSCRIBED AND SWORN to before me this 20 day of Dec, 1966



Fred M. Barrow Notary Public.