

STATE OF KANSAS
STATE CORPORATION COMMISSION

Give All Information Completely
Make Required Affidavit
Mail or Deliver Report to:
Conservation Division
State Corporation Commission
211 No. Broadway
Wichita, Kansas

WELL PLUGGING RECORD

Clark County, Sec. 4 Twp. 35S Rge. (E) 21 (W)

Location as "NE/CNW/SW" or footage from lines C SE NW

Lease Owner Petroleum, Inc.

Lease Name Tuttle "B" Well No. 1

Office Address 352 North Broadway, Wichita, Kansas

Character of Well (completed as Oil, Gas or Dry Hole) Dry Hole

Date well completed February 3, 1961

Application for plugging filed February 3, 1961

Application for plugging approved February 3, 1961

Plugging commenced February 4, 1961


Plugging completed February 4, 1961

Reason for abandonment of well or producing formation

No PRODUCIBLE ZONES

If a producing well is abandoned, date of last production NONE 19

Was permission obtained from the Conservation Division or its agents before plugging was commenced? Yes

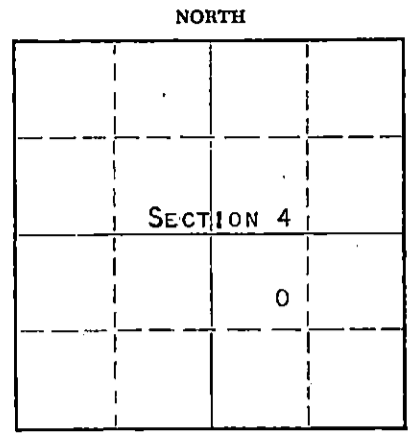

Locate well correctly on above Section Plat

Name of Conservation Agent who supervised plugging of this well W. L. Lackamp, Stafford, Kansas

Producing formation _____ Depth to top _____ Bottom _____ Total Depth of Well 5760 Feet

Show depth and thickness of all water, oil and gas formations.

OIL, GAS OR WATER RECORDS

CASING RECORD

| FORMATION | CONTENT | FROM | TO | SIZE | PUT IN | PULLED OUT |
|-----------|---------|------|----|--------|--------|------------|
| | | | | 13 3/8 | 67' | None |
| | | | | 8 5/8 | 657 | None |
| | | | | | | |
| | | | | | | |
| | | | | | | |
| | | | | | | |
| | | | | | | |

Describe in detail the manner in which the well was plugged, indicating where the mud fluid was placed and the method or methods used in introducing it into the hole. If cement or other plugs were used, state the character of same and depth placed, from _____ feet to _____ feet for each plug set.

Filled hole with mud 5760 feet to 600 feet
Plug set at 600 feet and cemented with 25 sacks through drill pipe, filled with mud to 40 feet, set wood plug at 40 feet and cemented with 10 sacks to bottom of cellar

STATE CORPORATION COMMISSION
2-15-61
FEB 15 1961

CONSERVATION DIVISION
Wichita, Kansas

(If additional description is necessary, use BACK of this sheet)

Name of Plugging Contractor Earl F. Wakefield
Address 515 Union Center Building, Wichita, Kansas

STATE OF KANSAS, COUNTY OF BARTON, ss.
DON SEARLE (employee of owner) or ~~#####~~ of the above-described

well, being first duly sworn on oath, says: That I have knowledge of the facts, statements, and matters herein contained and the log of the above-described well as filed and that the same are true and correct. So help me God.

(Signature) Don Searle
DIST. PROD. SUPT.
ROUTE 2, GREAT BEND, KANSAS
(Address)

SUBSCRIBED AND SWORN TO before me this 13TH day of FEBRUARY, 1961

Arthur J. Miles
Notary Public.

My commission expires APRIL 14, 1963



LEASE: TUTTLE "B" #1
 OPERATOR: PETROLEUM, INC.
 CONTRACTOR: EARL F. WAKEFIELD
 COMM: 1/13/61 COMP: 2/4/61

LOCATION: C SE NW
 SECTION 4-35S-21W
 CLARK COUNTY, KANSAS
 CASING: 13 3/8" at 67'
 8 5/8" at 657'

ELEVATION 1892 K.B.

| | |
|--------------------------|------|
| Sand and Clay | 30 |
| Red Bed | 60 |
| Clay and Shale | 100 |
| Sand | 120 |
| Shale and Red Bed | 210 |
| Clay and Shale | 505 |
| Shale, Streaks Anhydrite | 596 |
| Red Bed Shale and Gyp | 657 |
| Shale | 968 |
| Red Bed and Shale | 1550 |
| Shale and Lime Streaks | 1927 |
| Shale and Lime | 2260 |
| Shale, Lime, Anhydrite | 2357 |
| Lime and Shale | 2690 |
| Shale | 2804 |
| Lime and Shale | 2865 |
| Dolomite and Lime | 2885 |
| Chalky Lime and Shale | 3300 |
| Shale | 3333 |
| Shale, Streaks of Lime | 3465 |
| Lime and Shale | 3590 |
| Shale and Lime | 3708 |
| Lime and Shale | 4075 |
| Shale | 4357 |
| Shale and Lime | 4490 |
| Lime and Shale | 4575 |
| Shale and Chalky Lime | 4695 |
| Lime | 4956 |
| Lime with Shale | 4998 |
| Lime | 5577 |
| Sand | 5589 |
| Sand and Lime | 5615 |
| Lime | 5760 |
| T. D. | 5760 |

RECEIVED
 STATE CORPORATION COMMISSION
 FEB 10 1961
 CONSERVATION DIVISION
 Wichita, Kansas

STATE OF KANSAS)
) ss
 COUNTY OF SEDGWICK)

I hereby certify that the above is a true and correct copy of the log on the TUTTLE "B" #1 well, located C SE NW of Section 4, Township 35 South, Range 21 West, Clark County, Kansas.

EARL F. WAKEFIELD

By Fred S. Barber

Subscribed and sworn before me this 7th day of February, 1961.

Wanda W. Riley
 WANDA W. RILEY NOTARY PUBLIC

My commission expires January 25, 1965.