


STATE OF KANSAS  
STATE CORPORATION COMMISSION

## WELL PLUGGING RECORD

Give All Information Completely  
Make Required Affidavit  
Mail or Deliver Report to  
Conservation Division  
State Corporation Comm.  
245 North Water  
Wichita, KS 67202

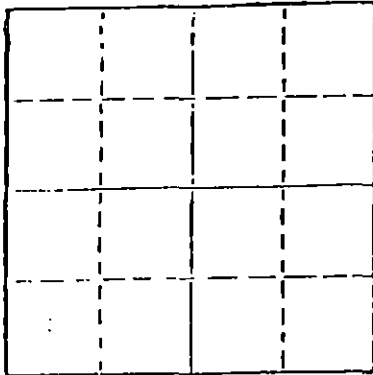

Locate well correctly on above  
Section Plat

Clark County. Sec. 1 Twp. 35S Rge. 21 E/W  
Location as "NE/CNW $\frac{1}{4}$ SW $\frac{1}{4}$ " or footage from lines

C NE  
Lease Owner Rains & Williamson Oil Co., Inc.  
Lease Name Tuttle Well No. #1  
Office Address 435 Page Court, 220 W. Douglas, Wichita, Ks.  
Character of Well (Completed as Oil, Gas or Dry Hole)  
Dry Hole

Date Well completed 4-16-78 19  
Application for plugging filed 4-16-78 19  
Application for plugging approved 4-16-78 19  
Plugging commenced 4-16-78 19  
Plugging completed 4-16-78 19  
Reason for abandonment of well or producing formation

Commercial quantities of oil not found  
If a producing well is abandoned, date of last production 19

Was permission obtained from the Conservation Division or  
its agents before plugging was commenced? Yes

Name of Conservation Agent who supervised plugging of this well Clarence Thomas, Jr.  
Producing formation Depth to top Bottom Total Depth of Well 5660'  
Show depth and thickness of all water, oil and gas formations.

## OIL, GAS OR WATER RECORDS

## CASING RECORD

FORMATION	CONTENT	FROM	TO	SIZE	PUT IN	PULLED OUT
				8 5/8"	807'	None

Describe in detail the manner in which the well was plugged, indicating where the mud fluid was placed and the method or methods used in introducing it into the hold. If cement or other plugs were used, state the character of same and depth placed, from feet to feet for each plug set.

Plug @ 900' w/70 sx.

Plug @ 40' w/10 sx.

Rat Hole 5 sx.

RECEIVED  
STATE CORPORATION COMMISSION  
MAY 05 1978  
CONSERVATION DIVISION  
Wichita, Kansas

(If additional description is necessary, use BACK of this sheet)

Name of Plugging Contractor Rains & Williamson Oil Co., Inc.

STATE OF Kansas COUNTY OF Sedgwick, ss.  
Wilson Rains, President of Rains & Williamson Oil Co., Inc. (employee of owner) or (owner or operator) of the above-described well, being first duly sworn on oath, says: That I have knowledge of the facts, statements, and matters herein contained and the log of the above-described well as filed and that the same are true and correct. So help me God.

(Signature)

*Wilson Rains*

435 Page Court, 220 W. Douglas, Wichita, Ks. 67202  
(Address)

SUBSCRIBED AND SWORN TO before me this 25 day of April, 1978

My commission expires

10-4-79

*Juanita M. Green*  
Juanita M. Green

Notary Public.



DRILLER'S LOG

COMPANY: Rains &amp; Williamson Oil Co., Inc.

SEC. 1 T. 35S R. 21W

WELL NAME: Tuttle #1

LOC. C NE

COUNTY: Clark

RIG NO. #8

TOTAL DEPTH 5660'

ELEVATION 1775 GL 1784 KB

COMMENCED: 4-2-78

COMPLETED: 4-16-78

CONTRACTOR: Rains &amp; Williamson Oil Co., Inc.

## CASING RECORD:

SURFACE: 8 5/8" @ 807' w/350 sx. Lite, 3% cc. and 200 sx. common, 3% cc.

PRODUCTION: D&amp;A

LOG

(Figures Indicate Bottom of Formations)

Redbed & Sand	380
Sand & Redbed	807
Redbed	900
Redbed & Clay	1627
Shale	2143
Shale & Lime	2422
Lime & Shale	4105
Lime, Shale & Sand	4305
Lime & Shale	4481
Lime	4540
Lime & Shale	5597
Lime	5660
<u>ROTARY TOTAL DEPTH</u>	<u>5660</u>

RECEIVED  
STATE CORPORATION COMMISSION  
MAY 05 1978

CONSERVATION DIVISION  
Wichita, Kansas

STATE OF Kansas)COUNTY OF Sedgwick)

SS:

I, Wilson Rains, President of Rains & Williamson Oil Co., Inc.

upon oath state that the above and foregoing is a true and correct copy of the log of the

Tuttle #1 well.

Wilson Rains  
Wilson Rains

Subscribed and sworn to before me this 25 day of April, 1978.

My Appointment Expires:

10-4-79

Juanita M. Green  
Juanita M. Green

