


Give All Information Completely
Make Required Affidavit
Mail or Deliver Report to:
Conservation Division
State Corporation Commission
212 No. Market
Wichita, Kansas

WELL PLUGGING RECORD

NORTH

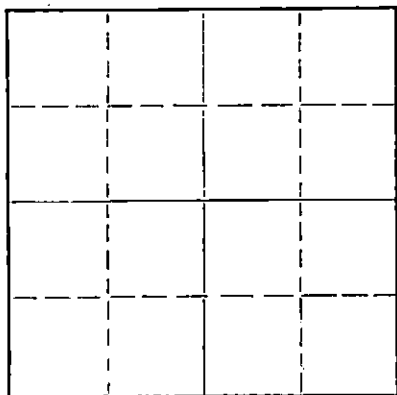

Locate well correctly on above
Section Plat

Seward County, Sec. 36 Twp. 34S Rge. (E) 32 (W)
Location as "NE/CNW/SW" or footage from lines. C SE NW
Lease Owner. Tilco, et al
Lease Name. Bird Well No. 1
Office Address. 200 Sutton Place, Wichita, Kansas
Character of Well (completed as Oil, Gas or Dry Hole) Dry Hole
Date well completed 10-11 1969
Application for plugging filed 10-11 1969
Application for plugging approved 10-11 1969
Plugging commenced 10-11 1969
Plugging completed 10-11 1969
Reason for abandonment of well or producing formation Dry Hole

If a producing well is abandoned, date of last production 19
Was permission obtained from the Conservation Division or its agents before plugging was commenced? Yes

Name of Conservation Agent who supervised plugging of this well Edger Eaves
Producing formation _____ Depth to top _____ Bottom _____ Total Depth of Well 5395 Feet
Show depth and thickness of all water, oil and gas formations.

OIL, GAS OR WATER RECORDS

CASING RECORD

FORMATION	CONTENT	FROM	TO	SIZE	PUT IN	PULLED OUT
				8 5/8"	1468	none

Describe in detail the manner in which the well was plugged, indicating where the mud fluid was placed and the method or methods used in introducing it into the hole. If cement or other plugs were used, state the character of same and depth placed, from _____ feet to _____ feet for each plug set.

Plugged with 35 sacks @ 728' & 15 sacks @ 45' to bottom of cellar.

RECEIVED
STATE CORPORATION COMMISSION
OCT 17 1969
CONSERVATION DIVISION
Wichita, Kansas


(If additional description is necessary, use BACK of this sheet)
Name of Plugging Contractor. Leben Drilling, Inc.
Address. Box 486, Great Bend, Kansas 67530

STATE OF KANSAS, COUNTY OF BARTON, ss.
Leslie Kite (employee of owner) or (owner or operator) of the above-described well, being first duly sworn on oath, says: That I have knowledge of the facts, statements, and matters herein contained and the log of the above-described well as filed and that the same are true and correct. So help me God.

(Signature) Leslie Kite
Box 486, Great Bend, Kansas
(Address)

SUBSCRIBED AND SWORN to before me this 16th day of October, 1969

Ulanda Nichols
Ulanda Nichols Notary Public.

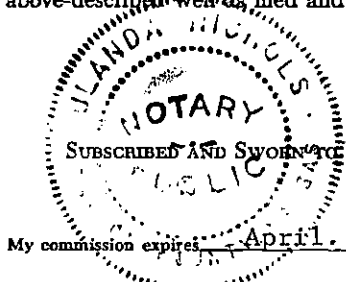

My commission expires April 1 1971

DRILLER'S LOG

COMPANY	TILCO, ET AL
CONTRACTOR	LEBEN DRILLING, INC.
FARM	BIRD #1
LOCATION	G SE NW SECTION 36-34S-32W
	SEWARD COUNTY, KANSAS
COMMENCED	9-29-69
COMPLETED	10-11-69

0	336	Surface Soils, Sand
336	999	Sand, Red Bed
999	1110	Sand
1110	1450	Red Bed, Shale
1450	1468	Anhydrite
1468	1569	Anhydrite, Red Bed
1569	1880	Red Bed, Shells
1880	2300	Shale, Shells, Lime
2300	2435	Shale, Shells
2435	2580	Shale
2580	3339	Shale, Lime
3339	3768	Lime, Shale
3768	4065	Shale, Lime
4065	4310	Shale
4310	4489	Shale, Lime
4489	4626	Lime, Shale
4626	5100	Lime
5100	5138	Lime
5138	5234	Lime, Shale
5234	5395	Lime
	<u>5395</u>	<u>RTD</u>

RECEIVED
STATE CORPORATION COMMISSION
OCT 17 1969
CONSERVATION DIVISION
Wichita, Kansas

8 5/8" 24# surface casing set @ 1468' cemented with 600 sacks Pozmix 6% gel & 2% cc, 235 sacks common with 2% cc.

I, Leslie Kite, do hereby certify that the above and foregoing is a true and correct copy of the log of the Bird #1 Well, located G SE NW, Section 36, Township 34 South, Range 32 West, Seward County, Kansas, as reflected by the records of Leben Drilling, Inc.

Leslie Kite

Leslie Kite

STATE OF KANSAS)
) SS
COUNTY OF BARTON)

Subscribed and sworn to and before me, a Notary Public, in and for Barton County, Kansas, this 16th day of October, 1969.

Ulanda Nichols

Ulanda Nichols

