


STATE OF KANSAS  
STATE CORPORATION COMMISSION

WELL PLUGGING RECORD

Give All Information Completely  
Make Required Affidavit  
Mail or Deliver Report to  
Conservation Division  
State Corporation Comm.  
245 North Water  
Wichita, KS 67202

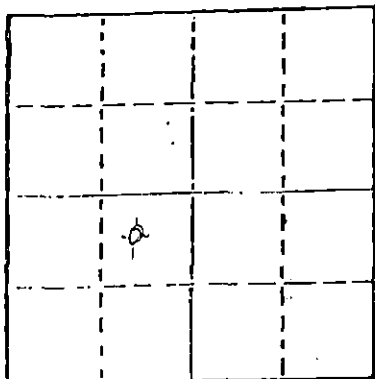

Locate well correctly on above  
Section Plat

Seward County, Sec. 34 Twp. 34S Rge. 32W E/W  
Location as "NE/CNW 1/4 SW 1/4" or footage from lines

200' SW of NW NE SW

Lease Owner Hasada Industries Energy Group

Lease Name Breen Renfro Well No. 1

Office Address Box 1532 Liberal, Kansas 67901

Character of Well (Completed as Oil, Gas or Dry Hole)

Dry Hole

Date Well completed 6-4 1980

Application for plugging filed 9-19 1980

Application for plugging approved 9-21 1980

Plugging commenced 11-3 1980

Plugging completed 11-6 1980

Reason for abandonment of well or producing formation

If a producing well is abandoned, date of last production 19

Was permission obtained from the Conservation Division or its agents before plugging was commenced? Yes

Name of Conservation Agent who supervised plugging of this well Clarence Thomas  
Producing formation Depth to top Bottom Total Depth of Well 6076

Show depth and thickness of all water, oil and gas formations.

OIL, GAS OR WATER RECORDS

CASING RECORD

FORMATION	CONTENT	FROM	TO	SIZE	PUT IN	PULLED OUT
				8 5/8	1488	none
				4 1/2	6076	2602

Describe in detail the manner in which the well was plugged, indicating where the mud fluid was placed and the method or methods used in introducing it into the hold. If cement or other plugs were used, state the character of same and depth placed, from feet to feet for each plug set.

Pump 20 sks. of cement & 1 sk. of hull's from 5921 to 5700

Spot 35 sks. of cement from 1500 to 1400

Spot 25 sks. of cement from 700 to 600

Put 10 sks. of cement from 40 to 0 Cut off & cap 8 5/8 3' below ground level.

DEC 24 1980  
CONSERVATION DIVISION  
Wichita, Kansas

(If additional description is necessary, use BACK of this report)

Name of Plugging Contractor Sargents Casing Pulling Ser. Box 506 Liberal, Kansas 67901 Ks.No. 511


STATE OF KANSAS COUNTY OF SEWARD, ss.  
Harold Box (employee of owner) or (owner or operator)

of the above-described well, being first duly sworn on oath, says: That I have knowledge of the facts, statements, and matters herein contained and the log of the above-described well as filed and that the same are true and correct. So help me God.

(Signature) Harold Box

P. O. Box 1532, Liberal, KS 67901  
(Address)

SUBSCRIBED AND SWORN TO before me this 22nd day of December, 1980

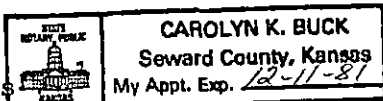

Carolyn K. Buck  
Notary Public.

My commission expires