


STATE OF KANSAS  
STATE CORPORATION COMMISSION  
CONSERVATION DIVISION  
P. O. BOX 17027  
WICHITA, KANSAS 67217

FORM CP-4

WELL PLUGGING RECORD

Seward County, Sec. 24 Twp. 34S Rge. 33 (X) W (W)

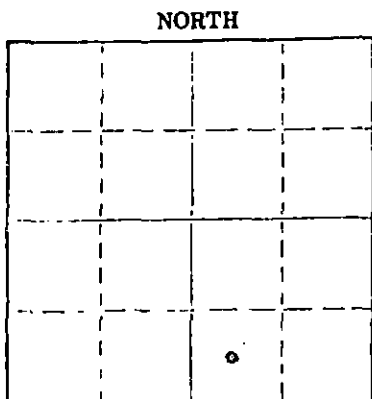

Locate well correctly on above Section Plat

Location as "NE/CNW/SW" or footage from lines  
Lease Owner Anadarko Production Company  
Lease Name Correll "A" Well No. 1  
Office Address Box 351, Liberal, Kansas 67901  
Character of Well (completed as Oil, Gas or Dry Hole) Oil  
Date well completed May 28 1969  
Application for plugging filed August 26 1975  
Application for plugging approved August 27 1975  
Plugging commenced September 8 1975  
Plugging completed September 9 1975  
Reason for abandonment of well or producing formation Formation Depleted

If a producing well is abandoned, date of last production N/A 19      
Was permission obtained from the Conservation Division or its agents before plugging was commenced? Yes

Name of Conservation Agent who supervised plugging of this well Clarence F. Thomas  
Producing formation Mississippian Depth to top 6300' Bottom 6320' Total Depth of Well 6654'  
Show depth and thickness of all water, oil and gas formations.

OIL, GAS OR WATER RECORDS

CASING RECORD

| FORMATION          | CONTENT        | FROM       | TO          | SIZE         | PUT IN       | PULLED OUT   |            |
|--------------------|----------------|------------|-------------|--------------|--------------|--------------|------------|
| <u>Mississippi</u> | <u>Chester</u> | <u>Oil</u> | <u>6303</u> | <u>6316</u>  | <u>8-5/8</u> | <u>1574'</u> | <u>-0-</u> |
|                    |                |            |             | <u>4-1/2</u> | <u>6652'</u> | <u>3003'</u> |            |
|                    |                |            |             |              |              |              |            |
|                    |                |            |             |              |              |              |            |
|                    |                |            |             |              |              |              |            |
|                    |                |            |             |              |              |              |            |

Describe in detail the manner in which the well was plugged, indicating where the mud fluid was placed and the method or methods used in introducing it into the hole. If cement or other plugs were used, state the character of same and depth placed, from      feet to      feet for each plug set.

Mixed 30 sacks cement, pumped plug to 5900'; Shot casing @ 5436', 4518', 3647', 3224' & free @ 3003'; spotted 60 sacks cement from 1400'-1600' and 15 sacks from surface to 40'.

RECEIVED  
STATE CORPORATION COMMISSION

NOV 18 1975

(If additional description is necessary, use BACK of this sheet)  
Name of Plugging Contractor Sargents Casing Pulling Service, Box 506  
Address Liberal, Kansas 67901

CONSERVATION DIVISION  
Wichita, Kansas

STATE OF KANSAS COUNTY OF SEWARD  
Anadarko Production Company (employee of owner) or (owner or operator) of the above-described

well, being first duly sworn on oath, says: That I have knowledge of the facts, statements, and matters herein contained and the log of the above-described well as filed and that the same are true and correct. So help me God.

(Signature) [Signature]  
P. O. Box 351, Liberal, Kansas 67901  
(Address)

NORMA JEAN TUCKER  
NOTARY PUBLIC  
Seward County, Kansas  
My Commission Expires this 17th day of November, 1975  
September 9, 1976

My commission expires      day of     , 19      
[Signature] Notary Public.

15-175-20056-0000

DRILLER'S LOG

WELL NAME: Correll "A" No. 1; COMPANY OPERATING: Anadarko Production Company  
 ADDRESS of COMPANY: Box 351 Liberal, Kansas 67901  
 WELL LOCATION: C 1/4 SW 1/4 SE 1/4,  
660' ft. North of South line,  
3275' ft. East of West line: Sec. 24, Twp. 34S, Rge. 33W, Seward County, Kansas  
 DRILLING STARTED May 1, 1969; DRILLING COMPLETED May 18, 1969  
 WELL COMPLETED May 24, 1969; WELL CONNECTED \_\_\_\_\_, 19\_\_\_\_  
 ELEVATION: 2807.1 ft. Ground Level; CHARACTER OF WELL (Oil, Gas, or Dry Hole) Oil

| OIL OR GAS SANDS OR ZONES - PERFORATIONS - ACIDIZING AND FRACTURING INFORMATION |      |      |              |              |                 |
|---|------|------|--------------|--------------|-----------------|
| Name  | From | To   | No. of Shots | Gallons Used | Kind Used       |
| Mississippian   | 6303 | 6316 | 26           | 250          | (Howco) Mod 202 |
|   |      |      |              |              |                 |
|   |      |      |              |              |                 |
CASING RECORD

| Size   | Amount Set | Sacks of Cement | Amount Pulled |
|--------|------------|-----------------|---------------|
| 8 5/8" | 1574 Feet  | 775             | None          |
| 4 1/2" | 6652 Feet  | 175             | None          |
| 2 3/8" | 6314 Feet  |                 |               |
|        |            |                 |               |

FORMATION RECORD

| Formation            | Top   | Bottom | Formation    | Top   | Bottom |
|----------------------|-------|--------|--------------|-------|--------|
| Sand & Redbed        | 0     | 651'   | Lime & Shale | 6086' | 6230'  |
| Sand & Clay          | 651'  | 1020'  | Lime & Sand  | 6230' | 6317'  |
| Redbed & Sand        | 1020' | 1350'  | Lime         | 6317' | 6645'  |
| Redbed               | 1350' | 1575'  | Total Depth  | 6645' |        |
| Anhydrite & Redbed   | 1575' | 1772'  |              |       |        |
| Redbed & Anhydrite   | 1772' | 2357'  |              |       |        |
| Anhydrite            | 2357' | 2477'  |              |       |        |
| Anhydrite & Dolomite | 2477' | 2675'  |              |       |        |
| Lime                 | 2675' | 2855'  |              |       |        |
| Lime & Shale         | 2855' | 4455'  |              |       |        |
| Lime                 | 4455' | 5560'  |              |       |        |
| Lime & Shale         | 5560' | 5889'  |              |       |        |
| Shale & Lime         | 5889' | 6086'  |              |       |        |

RESULTS of INITIAL PRODUCTION TEST: State test taken 5-29-69 Flowed 176.70 BO on 21/64"  
Choke in 24 hours.