


Give All Information Completely  
Make Required Affidavit  
Mail or Deliver Report to:  
Conservation Division  
State Corporation Commission  
P. O. Box 17027  
Wichita, Kansas 67217  
NORTH

WELL PLUGGING RECORD

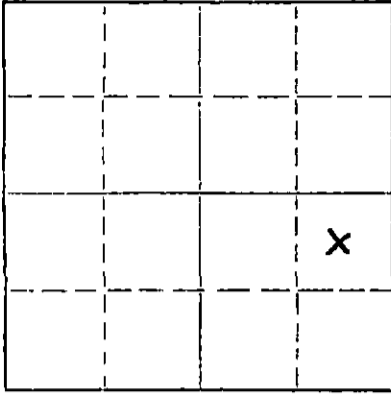

Locate well correctly on above Section Plat

Seward County, Sec. 23 Twp. 34S Rge. 33 (W)  
Location as "NE/CNW/SW" or footage from lines. NE-SE 1980 F/S & 660 F/East  
Lease Owner **Alpar Resources, Inc.**  
Lease Name **Wright** Well No. **1**  
Office Address **Box 906 Perryton, Texas 79070**  
Character of Well (completed as Oil, Gas or Dry Hole) **Oil & Gas**  
Date well completed **1-25** 19 **72**  
Application for plugging filed **Unknown by Sargents** 19 **-**  
Application for plugging approved **1-2** 19 **73**  
Plugging commenced **12-31** 19 **73**  
Plugging completed **1-3** 19 **74**  
Reason for abandonment of well or producing formation **Depleted**

If a producing well is abandoned, date of last production **9-4** 19 **73**  
Was permission obtained from the Conservation Division or its agents before plugging was commenced? **Yes**

Name of Conservation Agent who supervised plugging of this well **Ed Eves**  
Producing formation **Marmaton** Depth to top **5362** Bottom **5420** Total Depth of Well **6700** Feet  
Show depth and thickness of all water, oil and gas formations.

OIL, GAS OR WATER RECORDS

CASING RECORD

FORMATION	CONTENT	FROM	TO	SIZE	PUT IN	PULLED OUT
St. Louis	oil & saltwater	6572	6578	4 1/2	6689	2830
Marmaton	gas & saltwater	5362	5420	8 5/8	1621	None
Surface Sand	water	120	327			

Describe in detail the manner in which the well was plugged, indicating where the mud fluid was placed and the method or methods used in introducing it into the hole. If cement or other plugs were used, state the character of same and depth placed, from \_\_\_\_\_ feet to \_\_\_\_\_ feet for each plug set.

20 sks. of cement @ 5200 to 5100  
35 sks. of cement @ 1000 to 900  
15 sks. of cement @ 45 to 0

**St. Louis zone plugged off w/ Baker cast iron bridge plug set @ 5470 w/ 2 sax cement spotted on plug to 5450**

RECEIVED  
STATE CORPORATION COMMISSION

JAN 17 1974

CONSERVATION DIVISION  
Wichita, Kansas

(If additional description is necessary, use BACK of this sheet)

Name of Plugging Contractor **Sargents Casing Pulling Service** Kansas No. **511**  
Address **Box 506 Liberal, Kansas 67901**

STATE OF **Texas**, COUNTY OF **Ochiltree**, SS. **Bill Hair** (employee of owner) or ~~(owner or operator)~~ of the above-described well, being first duly sworn on oath, says: That I have knowledge of the facts, statements, and matters herein contained and the log of the above-described well as filed and that the same are true and correct. So help me God.

(Signature) *Bill Hair*

**Box 906 Perryton, Texas**  
(Address)

SUBSCRIBED AND SWORN TO before me this **15th** day of **January**, 19**74**

My commission expires **6-1-75**

*Fatay Dzungo*  
Notary Public.

# WELL LOG

COMPANY ALPAR RESOURCES, INC.

SEC. 23-34S-33W

FARM WRIGHT No. 1

LOC. NE-SE

TOTAL DEPTH 6700'

COUNTY Seward


COMM. Dec. 11, 1971 COMP. Dec. 28, 1971

CONTRACTOR Zenith Drilling Corporation, Inc.

CASING

8 5/8" @ 1622', w/800 sx.

4 1/2" @ 6690', w/325 sx.

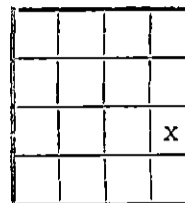

ELEVATION

PRODUCTION Oil

FIGURES INDICATE BOTTOM OF FORMATIONS

730	Sand		
1665	Red Bed		
1980	Red Bed/Anhydrite		
2390	Shale/Lime		
2915	Lime/Shale		
3150	Shale/Lime		
3555	Dolomite		
4095	Lime		
4240	Shale/Lime/Sand		
4600	Lime/Shale		
4798	Lime/Shale/Sand		
5010	Lime/Shale		
5150	Shale/Lime		
5360	Lime		
5490	Shale/Lime		
6451	Lime/Shale	6700 T.D.	Lime

RECEIVED  
STATE CORPORATION COMMISSION  
JAN 2 1974  
CONSERVATION DIVISION  
Wichita, Kansas

State of Kansas }  
County of Sedgwick } ss

I, C. Robert Buford, President of Zenith Drilling Corp., Inc.  
upon oath state the above and foregoing is a true and correct copy of the log of the #1 Wright well.

C. Robert Buford

Subscribed and sworn to before me this 6th day of January, 1972.

My Commission Expires: August 15, 1975.

Myron R. Murphy  
NOTARY PUBLIC

