


STATE OF KANSAS
STATE CORPORATION COMMISSION

Form CP-4

Give All Information Completely
Make Required Affidavit
Mail or Deliver Report to:
Conservation Division
State Corporation Commission
211 No. Broadway
Wichita, Kansas

WELL PLUGGING RECORD

NORTH

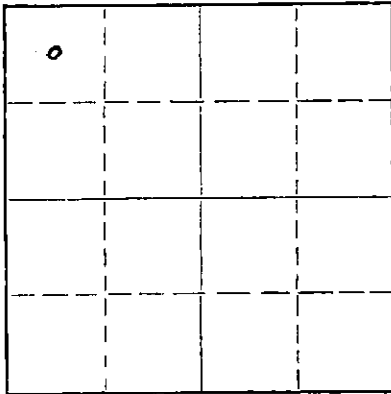

Locate well correctly on above
Section Plat

Seward County. Sec. 23 Twp. 34 Rge. 33 (E) (W)
Location as "NE/CNW/SW" or footage from lines. NW NW

Lease Owner T. W. Mahoney

Lease Name Bozarth

Well No. 1

Office Address Box 1257 Liberal, Kansas

Character of Well (completed as Oil, Gas or Dry Hole) Dry Hole

Date well completed

19

Application for plugging filed Oct. 16

1965

Application for plugging approved Hugh Scott Oct. 16

1965

Plugging commenced Oct. 17

1965

Plugging completed Oct. 17

1965

Reason for abandonment of well or producing formation

If a producing well is abandoned, date of last production

19

Was permission obtained from the Conservation Division or its agents before plugging was commenced? Hugh Scott

Name of Conservation Agent who supervised plugging of this well Hugh Scott

Producing formation Depth to top Bottom Total Depth of Well 6674 Feet

Show depth and thickness of all water, oil and gas formations.

OIL, GAS OR WATER RECORDS

CASING RECORD

| FORMATION | CONTENT | FROM | TO | SIZE | PUT IN | PULLED OUT |
|-----------|---------|------|------|-------|-------------------|------------|
| Surface | | 0 | 1376 | 8-5/8 | 1 1376 | None |
| | | | | | | |
| | | | | | | |
| | | | | | | |
| | | | | | | |
| | | | | | | |
| | | | | | | |

Describe in detail the manner in which the well was plugged, indicating where the mud fluid was placed and the method or methods used in introducing it into the hole. If cement or other plugs were used, state the character of same and depth placed, from feet to feet for each plug set.

plug hole by Halliburton thorough drill PIPE set plug @700'
with 35 sack cement and 2nd plug @45' with 15 sack cement job done 7:30AM

RECEIVED
STATE CORPORATION COMMISSION

OCT 19 1965

CONSERVATION DIVISION
Wichita, Kansas

(If additional description is necessary, use BACK of this sheet)
Name of Plugging Contractor Mahoney Drilling Co. Inc.
Address 402 East Park, Liberal, Kansas

STATE OF Kansas, COUNTY OF Seward, ss.
T. W. Mahoney (owner or (owner or operator) of the above-described

well, being first duly sworn on oath, says: That I have knowledge of the facts, statements, and matters herein contained and the log of the above-described well as filed and that the same are true and correct. So help me God.

(Signature)

T. W. Mahoney

Box 1257

(Address)

Liberal, Kan.

SUBSCRIBED AND SWORN TO before me this 18 day of October, 1965

My commission expires January 24, 1968

George W. Cannahan Jr.

Notary Public.



Bozarth # 1
 Sec. 23-34-33
 Seward County, Kansas

Set 8-5/8" 1376 750 Sx Cement
 Cement did circulate.
 Set Plug @700' W/35 Sx cement
 Set plug @45' W/15 Sx Cement.
 Plug 10-17-65 Complete@7:30AM

| | |
|--|-----------|
| Sand & Gyp | 0-270 |
| Sand & Red Bed | 270-1000 |
| Red Bed & Shells | 1000-1025 |
| G. Sand | 1025-1190 |
| Gyp & Shells | 1190-1377 |
| Red Bed | 1377-1440 |
| Shale Shale & XXXXXX Anhydrite | 1440-2745 |
| Lime & Shale | 2745-2925 |
| Shale-Ch Lime | 2925-3050 |
| Lime & Shale | 3050-3355 |
| Shale- Ch Streaks | 3355-3570 |
| Lime & Shale | 3570-3905 |
| Shale & Lime | 3905-4047 |
| Lime & Shale | 4047-4733 |
| Lime | 4733-4912 |
| Lime & Shale | 4912-4972 |
| Lime | 4972-5341 |
| Lime Wshale strk | 5341-5432 |
| Lime | 5432-5563 |
| ShaleW/Lime strk | 5563-5693 |
| Lime & Shale | 5693-6037 |
| Lime, shale & sand | 6037-6095 |
| Lime -Shale | 6095-6331 |
| Lime | 6331-6392 |
| Shale-Lime | 6392-6452 |
| Lime | 6452-6478 |
| Lime W/chert | 6478-6530 |
| Lime | 6530-6618 |
| Lime -Chert | 6618-6663 |
| Lime | 6663-6674 |
| T.D. | 6674 |

RECEIVED
 STATE CORPORATION COMMISSION

OCT 19 1965

This is a true and exact copy of the formation ~~xxxx~~ Taken From the Daily Drilling Reports. CONSERVATION DIVISION
 Wichita, Kansas

T. W. Mahoney
 T. W. Mahoney, President

State of Kansas
 County of Seward

Sworn to before me this 18 Day of October, 1965

George W. Carnahan, Jr.
 George W. Carnahan, Jr.
 Notary Public

My Commission Expires January 24, 1968