

STATE OF KANSAS
STATE CORPORATION COMMISSION

WELL PLUGGING RECORD

Give All Information Completely
Make Required Affidavit
Mail or Deliver Report to:
Conservation Division
State Corporation Commission
211 No. Broadway
Wichita, Kansas

Seward County. Sec. 23 Twp. 34 Rge. (E) 33 (W)

Location as "NE/CNW/SW" or footage from lines C SE NW

Lease Owner Panhandle Eastern Pipe Line Company

Lease Name Bozarth Well No. "B" 1-23

Office Address Box 351, Liberal, Kansas

Character of Well (completed as Oil, Gas or Dry Hole) Dry Hole

Date well completed 7-10- 1958

Application for plugging filed 7-11- 1958

Application for plugging approved 7-15- 1958

Plugging commenced 7-18- 1958


Plugging completed 7-19- 1958

Reason for abandonment of well or producing formation Making too much salt water for economical production?

If a producing well is abandoned, date of last production None 19

Was permission obtained from the Conservation Division or its agents before plugging was commenced? Yes

NORTH

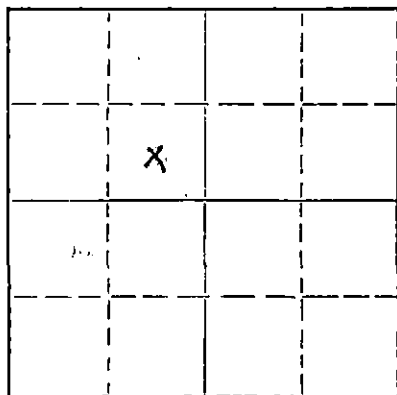

Locate well correctly on above Section Plat

Name of Conservation Agent who supervised plugging of this well Mr. M. A. Rives

Producing formation Krider Depth to top 2664 Bottom 2694 Total Depth of Well 2753 Feet

Show depth and thickness of all water, oil and gas formations.

OIL, GAS OR WATER RECORDS

CASING RECORD

FORMATION	CONTENT	FROM	TO	SIZE	PUT IN	PULLED OUT
Krider	Gas & Water	2664	2694	7"	707	0
				4 1/2"	2745	1816

Describe in detail the manner in which the well was plugged, indicating where the mud fluid was placed and the method or methods used in introducing it into the hole. If cement or other plugs were used, state the character of same and depth placed, from _____ feet to _____ feet for each plug set.

A cement plug was spotted, with 12 sacks using a bailer from plug back depth of 2709' past the perforations in the 4 1/2" casing. The well was loaded with water and the casing shot at 1816'. The well was then pressured up on the 4 1/2" casing until circulation was obtained and then 15 sacks of Gel were introduced. Pulled 1816' of 4 1/2" casing and bailed hole to 600'. Set rock bridge and dumped 10 sacks cement. Mudded hole to 35' and set rock bridge. Cemented to base of cellar.

(If additional description is necessary, use BACK of this sheet)

Name of Plugging Contractor Glen and Smith Pipe Pulling Company

Address 204 E. 6th Street, Ellinwood, Kansas

STATE OF Kansas, COUNTY OF Seward, ss.

E. C. Myers

(employee of owner) or (owner or operator) of the above-described

well, being first duly sworn on oath, says: That I have knowledge of the facts, statements, and matters herein contained and the log of the above-described well as filed and that the same are true and correct. So help me God.

(Signature) E. C. Myers

(Address)

SUBSCRIBED AND SWORN TO before me this 25th day of July, 1958

Charles L. Bellard
Notary Public.

My Commission expires November 14, 1960

My commission expires

RECEIVED
STATE CORPORATION COMMISSION

PLUGGING
FILE SEC. 23 T. 34 R. 33W
BOOK PAGE 115 LINE 16

JUL 29 1958

CONSERVATION DIVISION
Wichita, Kansas

DRILLER'S LOG

WELL NAME: Bozarth "B" 1-23 ; COMPANY OPERATING: Panhandle Eastern Pipe Line Co:
 ADDRESS of COMPANY: Box 351, Liberal, Kansas:

WELL LOCATION: 1/4 SE 1/4 NW 1/4,
3115 ft. North of South line,
2033 ft. East of West line; Sec. 23 , Twp. 34S , Rge. 33W , Seward County, Kansas

DRILLING STARTED June 7 , 1958 ; DRILLING COMPLETED June 14 , 1958
 WELL COMPLETED July 10 , 1958 ; WELL CONNECTED _____ , 19____

ELEVATION: 2839 ft. Ground Level; CHARACTER OF WELL (Oil, Gas, or Dry Hole) Dry Hole

OIL OR GAS SANDS OR ZONES - PERFORATIONS - ACIDIZING AND FRACTURING INFORMATION					
Name	From	To	No. of Shots	Gallons Used	Kind Used
Krider	2685	2694	28	10,000	15% acid
"	2664	2682	36	8,000 w/1/2# sd.	5% gel acid

CASING RECORD

Size	Amount Set	Sacks of Cement	Amount Pulled
4 1/2"	2745	125	0

FORMATION RECORD

Formation	Top	Bottom	Formation	Top	Bottom
Hollenburg	2581				
Herrington	2629				
Krider	2657				

RESULTS of INITIAL PRODUCTION TEST: _____

PLUGGING

FILE SEC. 23 T. 34 R. 33W
 BOOK PAGE 115 LINE 16