


STATE OF KANSAS  
STATE CORPORATION COMMISSION

Give All Information Completely  
Make Required Affidavit  
Mail or Deliver Report to:  
Conservation Division  
State Corporation Commission  
212 No. Market  
Wichita, Kansas

WELL PLUGGING RECORD

Seward County, Sec. 20 Twp. 34S Rge. 33 (W)  
1820' FEL & 1980' FNL

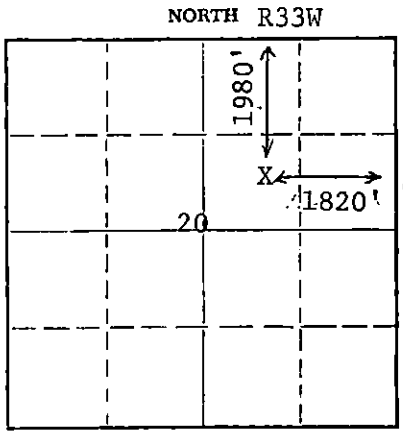

Locate well correctly on above  
Section Plat

Location as "NE/CNW/SW" or footage from lines  
Lease Owner Cities Service Oil Company  
Lease Name Stevesson A Well No. 3  
Office Address 3545 N.W. 58th Street, Okla. City, Okla. 73112  
Character of Well (completed as Oil, Gas or Dry Hole) Dry Hole  
Date well completed November 14, 1975  
Application for plugging filed November 15, 1975  
Application for plugging approved November 17, 1975  
Plugging commenced November 14, 1975  
Plugging completed November 14, 1975  
Reason for abandonment of well or producing formation Dry Hole

If a producing well is abandoned, date of last production N/A 19  
Was permission obtained from the Conservation Division or its agents before plugging was commenced? Yes

Name of Conservation Agent who supervised plugging of this well Clarence Thomas  
Producing formation ----- Depth to top ----- Bottom ----- Total Depth of Well 1662 Feet  
Show depth and thickness of all water, oil and gas formations.

OIL, GAS OR WATER RECORDS

CASING RECORD

FORMATION	CONTENT	FROM	TO	SIZE	PUT IN	PULLED OUT
Red Cave	Dry	1602	1662	8-5/8"	1599'	None

Describe in detail the manner in which the well was plugged, indicating where the mud fluid was placed and the method or methods used in introducing it into the hole. If cement or other plugs were used, state the character of same and depth placed, from \_\_\_\_\_ feet to \_\_\_\_\_ feet for each plug set. On 11-12-75, ran & set CIBP @ 1590'. Dumped 2 sx cmt to 1582'. Filled 8-5/8" Csg w/DM. and on 11/14/75, spotted 8 sx cement plug from 3 to 30'. Cut off 8-5/8" casing 3' below GL, at which point a steel cap with well name and date was welded on.

RECEIVED  
STATE CORPORATION COMMISSION  
DEC 10 1975  
CONSERVATION DIVISION  
WICHITA, KANSAS

(If additional description is necessary, use BACK of this sheet)  
Name of Plugging Contractor J. & R. Roustabout Service, P. O. Box 768  
Address Liberal, Kansas 67901

STATE OF Oklahoma, COUNTY OF Oklahoma, ss.  
Cities Service Oil Company (employee of owner) or ~~owner or operator~~ of the above-described well, being first duly sworn on oath, says: That I have knowledge of the facts, statements, and matters herein contained and the log of the above-described well as filed and that the same are true and correct. So help me God.

(Signature) H. E. Massey H. E. Massey  
Operations Manager  
3545 NW 58th, Oklahoma City, Oklahoma 73112  
(Address)

SUBSCRIBED AND SWORN to before me this 5th day of December, 1975

My commission expires June 25, 1977  
Dorothy L. St. George Notary Public.

STEVENSON "A" 3

FORMATION, TESTING AND COMPLETION RECORD

Show Drill Stem Tests,  
Well Stimulation and  
Production Tests

Formation	Top	Bottom
Soil, Sand & Clay	0	700
Red Bed	700	905
Anhydrite	905	960
Red Bed & Anhydrite	960	1,025
Gloretta Sand	1,025	1,225
Shale & Shells	1,225	1,335
Red Bed - Shells	1,335	1,560
Anhydrite	1,560	1,600
Red Cave	1,600	1,662
TD		1,662
P.B.T.D		1,582

None

RECEIVED  
STATE CORPORATION COMMISSION  
JAN 9 1976  
CONSERVATION DIVISION  
Wichita, Kansas

## FORMATION, TESTING AND COMPLETION RECORD

Show Drill Stem Tests,  
Well Stimulation and  
Production Tests

Formation	Top	Bottom	
Soil, Sand & Clay	0	700	None
Red Bed	700	905	
Anhydrite	905	960	
Red Bed & Anhydrite	960	1,025	
Gloretta Sand	1,025	1,225	
Shale & Shells	1,225	1,335	
Red Bed - Shells	1,335	1,560	
Anhydrite	1,560	1,600	
Red Cave	1,600	1,662	
TD		1,662	
P.B.T.D		1,582	

LOG 10 1975