


TC

STATE OF KANSAS
 STATE CORPORATION COMMISSION
 Give All Information Completely
 Make Required Affidavit
 Mail or Deliver Report to:
 Conservation Division
 State Corporation Commission
 211 No. Broadway
 Wichita, Kansas

WELL PLUGGING RECORD

Seward County, Sec. 19 Twp. 34S Rge. (E) 33 (W)
 Location as "NE/CNW/SW" or footage from lines C SW NE
 Lease Owner Cities Service Petroleum Company
 Lease Name Fincham "B" Well No. 1
 Office Address Box 1147 Liberal, Kansas
 Character of Well (completed as Oil, Gas or Dry Hole) Dry hole
 Date well completed 3-28- 19 61
 Application for plugging filed 4-18- 19 61
 Application for plugging approved 19
 Plugging commenced 4-12- 19 61
 Plugging completed 4-13- 19 61
 Reason for abandonment of well or producing formation Dry hole

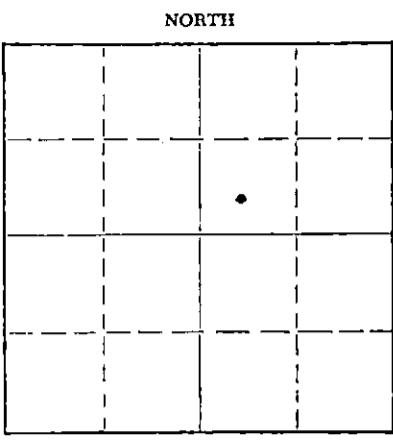

Locate well correctly on above Section Plat

If a producing well is abandoned, date of last production 19
 Was permission obtained from the Conservation Division or its agents before plugging was commenced? Yes. Verbal permission from Mr. W. L. Lackamp.

Name of Conservation Agent who supervised plugging of this well Mr. W. L. Lackamp
 Producing formation Dry hole Depth to top Bottom Total Depth of Well 6686 Feet
 Show depth and thickness of all water, oil and gas formations.

OIL, GAS OR WATER RECORDS

CASING RECORD

FORMATION	CONTENT	FROM	TO	SIZE	PUT IN	PULLED OUT
Chester	Dry	6360	6471	8 5/8	2250	
Chester	Dry	6238	6246	5 1/2	6550	
Chester	Dry	6179	6222			
Morrow S ₂ Sand	Dry	6102	6112			
Marmaton	Dry	5248	5254			
Lansing	Dry	4972	4990			
Lansing	Dry	4792	4799			
Toront.	Dry	4426	4430			
LeCompton	Dry	4116	4121			

Describe in detail the manner in which the well was plugged, indicating where the mud fluid was placed and the method or methods used in introducing it into the hole. If cement or other plugs were used, state the character of same and depth placed, from feet to feet for each plug set.

Council Grove Dry 3678 3754

Spotted 20 sx cement, 1559' to 1589' filled up with mud to 650'
 Spotted 20 sx cement, 650' to 580' filled up with mud to 40'
 Spotted 10 sx cement 40' to top

RECEIVED
 STATE CORPORATION COMMISSION
 JUN 7 1961
 CONSERVATION DIVISION
 Wichita, Kansas

(If additional description is necessary, use BACK of this sheet)

Name of Plugging Contractor Daco Lease and Well Service
 Address Borger, Texas

STATE OF Seward Kansas, COUNTY OF Seward, ss.
I, W. J. Devaney (employee of owner) or (owner) of the above-described well, being first duly sworn on oath, says: That I have knowledge of the facts, statements, and matters herein contained and the log of the above-described well as filed and that the same are true and correct. So help me God.

(Signature) [Signature]
Box 1147 Liberal, Kansas
 (Address)

SUBSCRIBED AND SWORN to before me this 12th day of May, 1961

My commission expires 5-23-61

J. T. Mabrey
 Notary Public



WELL LOG BUREAU—KANSAS GEOLOGICAL SOCIETY

508 East Murdock,

Wichita, Kansas


Company- CITIES SERVICE PETROLEUM
 Farm- Fincham "B" No. 1

SEC. 19 T. 34 R. 33W
 C SW NE

Total Depth. 6686'
 Comm. 11-24-60 Comp. 12-16-60
 Shot or Treated.
 Contractor. Rine Drlg.
 Issued. 7-22-61

County Seward

KANSAS

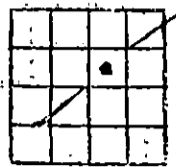

Elevation. 2894' RB

Production. Dry

Figures Indicate Bottom of Formations.

sand, red bed	1615
red bed, anhydrite	1910
anhydrite	1996
anhydrite, sand	2253
anhydrite	2432
anhydrite, salt ?	2616
anhydrite, lime, shale	2775
lime, shale	2857
anhydrite, lime	2960
anhydrite, lime, dolomite	
& shale	3051
lime	3188
lime	3705
lime, shale	3938
lime	3997
lime, chert	4048
lime	4200
lime, shale	4319
lime	4340
lime, shale, sand	4395
lime, shale	4514
lime	4628
lime	5554
lime, shale	5766
lime	5860
shale, lime	6126
lime, sand	6191
lime, shale	6291
lime	6423
lime, shale	6480
sand, lime	6545
lime	6577
St. Genevieve	6655
sdv lime	6686
Total Depth	

TOPS: SCOUT	
Winfield	2724
Heebner	4360
Toronto	4380
Lansing	4490
Marmaton	5229
Morrow	5848
Morrow Sandy Lime	6101
Chester	6126
Chester Sandy Lime	6441
Chester Sand	6466
St. Genevieve	6498
St. Louis	6618