

STATE OF KANSAS
STATE CORPORATION COMMISSION

WELL PLUGGING RECORD

Give All Information Completely
Make Required Affidavit
Mail or Deliver Report to
Conservation Division
State Corporation Comm.
245 North Water
Wichita, KS 67202

Seward County, Sec. 17 Twp. 34S Rge. 34 ~~N~~/W
Location as "NE/CNW/SW" or footage from lines
C-SW 1/2 NE 1/2

Lease Owner Cities Service Company
Lease Name Brown C Well No. 2
Office Address 3545 N.W. 58th Street- Okla. City, Ok 73112


Character of Well (Completed as Oil, Gas or Dry Hole)
Gas

Date Well completed August 8, 1968
Application for plugging filed May 1, 1980
Application for plugging approved May 6, 1980
Plugging commenced May 15, 1980
Plugging completed May 17, 1980

Reason for abandonment of well or producing formation
Uneconomical volumes of Gas since 1972

If a producing well is abandoned, date of last production
July 10 1973

Was permission obtained from the Conservation Division or
its agents before plugging was commenced? Yes

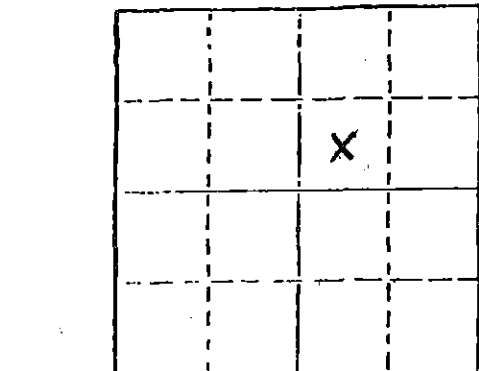

Locate well correctly on above
Section Plat

Name of Conservation Agent who supervised plugging of this well Clarence Thomas
Producing formation Toronto Depth to top 4343 Bottom 4348 Total Depth of Well 4558
Show depth and thickness of all water, oil and gas formations.

OIL, GAS OR WATER RECORDS

CASING RECORD

FORMATION	CONTENT	FROM	TO	SIZE	PUT IN	PULLED OUT

Describe in detail the manner in which the well was plugged, indicating where the mud fluid was placed and the method or methods used in introducing it into the hold. If cement or other plugs were used, state the character of same and depth placed, from 822' feet to 522' feet for each plug set.

FL @2180', Ran Baker CIBP on WL, set @ 4295'. Dumped 1 sack cement on B.P. Ran 141 jts. 2-3/8" EUE tbg open ended to 4252. Displaced hole w/62 bbls 9.5 mud. Pulled tbg 822' spotted 25 sack cement plug 822' to 522'. Pulled tbg. to 93', spotted 10 sack cement plug to surface. Poo H w/tbg. Dug out and cut off 8-5/8" and 4-1/2" csg, welded cap on 8-5/8" csg.

RECEIVED
STATE CORPORATION COMMISSION
MAY 20 1980
CONSERVATION DIVISION
WICHITA, KANS.

(If additional description is necessary, use BACK of this sheet)

Name of Plugging Contractor Sargent's Casing Pulling Co.

STATE OF Oklahoma COUNTY OF Oklahoma, ss.
H. E. Massey (employee of ~~xxxxxx~~) or (~~xxxxxx~~) operator
of the above-described well, being first duly sworn on oath, says: That I have knowledge of the facts, statements, and matters herein contained and the log of the above-described well as filed and that the same are true and correct. So help me God.

(Signature) H. E. Massey H. E. Massey
3545 N.W. 58th Street, Oklahoma City, Oklahoma
(Address) 73112

SUBSCRIBED AND SWORN TO before me this 20th day of May, 1980

Joyce S. Darter
Joyce S. Darter Notary Public.

My commission expires June 10, 1980