

STATE OF KANSAS  
STATE CORPORATION COMMISSION

Form CP-4

Give All Information Completely  
Make Required Affidavit  
Mail or Deliver Report to:  
Conservation Division  
State Corporation Commission  
212 No. Market  
Wichita, Kansas 67202

WELL PLUGGING RECORD

Seward County, Sec. 16 Twp. 34 Rgs. 33 ~~XX~~ (W)

Location as "NE/CNW/SW" or footage from lines NE SW

Lease Owner Cities Service Oil Company

Lease Name Salley "C" Well No. 2

Office Address Box 1098, Liberal, Kansas 67901

Character of Well (completed as Oil, Gas or Dry Hole) Gas

Date well completed 8-3 19 70

Application for plugging filed 8-17 19 70

Application for plugging approved 8-19 19 70


Plugging commenced 8-19- 19 70

Plugging completed 8-22 19 70

Reason for abandonment of well or producing formation Depleted

If a producing well is abandoned, date of last production 5-13 19 70

Was permission obtained from the Conservation Division or its agents before plugging was commenced? Yes

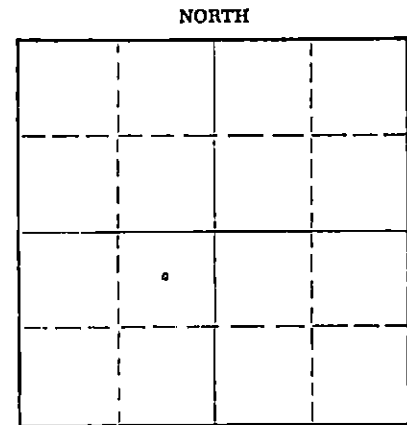

Locate well correctly on above Section Flat

Name of Conservation Agent who supervised plugging of this well E. Eves

Producing formation Toronto Depth to top 4338 Bottom 4342 Total Depth of Well 6451 Feet

Show depth and thickness of all water, oil and gas formations.

OIL, GAS OR WATER RECORDS

CASING RECORD

FORMATION	CONTENT	FROM	TO	SIZE	PUT IN	PULLED OUT
Toronto	Gas, Oil & Water	4338	4342	8-5/8"	2794	None
				5-1/2"	4475	2776

Describe in detail the manner in which the well was plugged, indicating where the mud fluid was placed and the method or methods used in introducing it into the hole. If cement or other plugs were used, state the character of same and depth placed, from feet to feet for each plug set.

Pumped 20 sx 3800-4024' w/ 600#

Drilling Mud 3800'-900'

35 sx Cement 900'-800'

Drilling Mud 800'- 45'

15 sx Cement 45'- 0'

P & A

RECEIVED  
STATE CORPORATION COMMISSION  
AUG 25 1970  
CONSERVATION DIVISION  
Wichita, Kansas

(If additional description is necessary, use BACK of this sheet)

Name of Plugging Contractor Sargent's Casing Pulling Service

Address 620 S. Lincoln, Liberal, Kansas

STATE OF KANSAS, COUNTY OF SEWARD, ss.

C. A. Nenny (employee of owner) or (owner or operator) of the above-described well, being first duly sworn on oath, says: That I have knowledge of the facts, statements, and matters herein contained and the log of the above-described well as filed and that the same are true and correct. So help me God.

(Signature) C. A. Nenny Dist. Engineer

Box 1098, Liberal, Kansas 67901

(Address)

SUBSCRIBED AND SWORN TO before me this 24th day of August, 19 70.

J. T. Mabrey  
Notary Public.

My commission expires 5-23-73

15-175-00018-0000

RECEIVED  
STATE CORPORATION COMMISSION  
AUG 19 1970  
CONSERVATION DIVISION  
Wichita, Kansas

DRILLER'S WELL LOG

LEASE: Salley "C" 2  
OWNER: Cities Service Oil Co.  
CONTRACTOR: Holm Drilling Co.  
LOCATION: NE SW Sec. 16, 34S-33W  
Seward County, Kansas

ELEVATION: 2829 G.L.  
CASING: 8-5/8" - 32# - J-55-2794'  
D.V. Tool at 705'. Top  
Cem/500 sx. Bottom/500 sx.  
5-1/2" - 4475'/200 sx.

---

Clay & Sand	0' - 300'
Sand & Red Bed	300' - 725'
Red Bed	725' - 850'
Red Bed & Anhydrite	850' - 1070'
Red Bed	1070' - 1430'
Anhydrite & Shale	1430' - 1765'
Shale & Shells	1765' - 2255'
Lime & Shale	2255' - 2525'
Lime	2525' - 2795'
Lime & Shale	2795' - 2940'
Lime	2940' - 3450'
Lime & Shale	3450' - 3957'
Lime	3957' - 4032'
Lime & Shale	4032' - 4740'
Lime	4740' - 5575'
Lime & Shale	5575' - 5779'
Shale	5779' - 6030'
Sand	6030' - 6045'
Sand & Shale	6045' - 6065'
Lime & Shale	6065' - 6310'
Lime	6310' - 6380'
Lime & Shale	6380' - 6414' T.D.
P.B.	4600'

---

We certify that the above log is true and correct to the best of our knowledge and belief.

CITIES SERVICE OIL COMPANY

*R. L. Higginbottom*  
R. L. Higginbottom  
District Manager