


STATE OF KANSAS  
STATE CORPORATION COMMISSION  
Give All Information Completely  
Make Required Affidavit  
Mail or Deliver Report to:  
Conservation Division  
State Corporation Commission  
212 No. Market  
Wichita, Kansas

WELL PLUGGING RECORD

Morton County, Sec. 29 Twp. 34 Rge. (E) 43 (W)  
Location as "NE/CNW\*SW\*" or footage from lines C SE 1/4 SW 1/4  
Lease Owner Anadarko Production Company  
Lease Name Interstate Unit Well No. 68  
Office Address Box 351, Liberal, Kansas 67901  
Character of Well (completed as Oil, Gas or Dry Hole) Oil  
Date well completed September 6 19 64  
Application for plugging filed April 21 19 70  
Application for plugging approved April 24 (verbal) 19 70  
Plugging commenced May 26 19 70  
Plugging completed June 19 19 70  
Reason for abandonment of well or producing formation Water, oil ratio too high.  
Uneconomical to produce.  
If a producing well is abandoned, date of last production March 18 19 70  
Was permission obtained from the Conservation Division or its agents before plugging was commenced? Yes

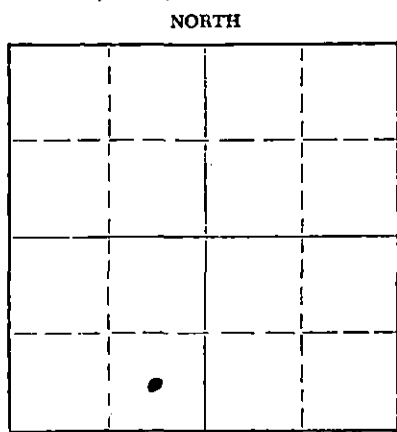

Locate well correctly on above Section Plat

Name of Conservation Agent who supervised plugging of this well Edgar Eves, Sublette, Kansas  
Producing formation Purdy Morrow Depth to top 4176 Bottom 4188 Total Depth of Well 4255 Feet  
Show depth and thickness of all water, oil and gas formations.

OIL, GAS OR WATER RECORDS				CASING RECORD		
FORMATION	CONTENT	FROM	TO	SIZE	PUT IN	PULLED OUT
Purdy Morrow	Oil	4176	4188	8 5/8"	1216	None
				5 1/2"	4252	2312


Describe in detail the manner in which the well was plugged, indicating where the mud fluid was placed and the method or methods used in introducing it into the hole. If cement or other plugs were used, state the character of same and depth placed, from \_\_\_\_\_ feet to \_\_\_\_\_ feet for each plug set.  
Squeezed perfs with 40 sacks from 4157' - TD. Spotted 60 sacks at 4157'. 70 sacks spotted at 1200'. 35 sacks spotted at 600'. 20 sacks spotted at 50' to surface. Hole filled with heavy mud between plugs.

RECEIVED  
STATE CORPORATION COMMISSION  
JUN 29 1970  
CONSERVATION DIVISION  
Wichita, Kansas

(If additional description is necessary, use BACK of this sheet)  
Name of Plugging Contractor Sargent's Casing Pulling Service  
Address Liberal, Kansas

STATE OF Kansas, COUNTY OF Seward, ss.  
V. K. Downey (employee of owner) or (owner/operator) of the above-described well, being first duly sworn on oath, says: That I have knowledge of the facts, statements, and matters herein contained and the log of the above-described well as filed and that the same are true and correct. So help me God.

(Signature) V. K. Downey  
Box 351, Liberal, Kansas 67901  
(Address)

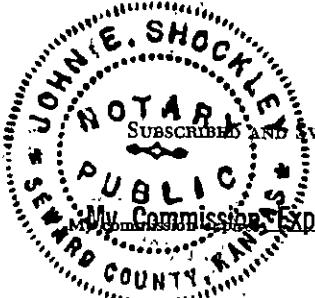

Subscribed and sworn to before me this 24th day of June, 19 70.  
John E. Shockley  
John E. Shockley Notary Public.

FORMATION	FROM	TO	NO. OF FEET	DRILL TIME	FORMATION	FROM	TO	NO. OF FEET	DRILL TIME
Sand, clay, gravel	0	150							
Sand, gyp	150	190							
Redbed, gyp, shale	190	235							
Redbed, gyp, shells	235	557							
Redbed, gyp, shale	557	769							
Gyp, redbed, salt	769	1000							
Gyp, redbed, shells	1000	1208							
Anhydrite, shells, gyp	1208	1218							
Anhydrite, shale	1218	1809							
Lime & shale	1809	3895							
Lime	3895	3987							
Lime, shale	3987	4255							
Total Depth	4255								

Completion Record:

Drilled well to 4255'. Ran Schlumberger to 4255'. Ran 5 1/2" casing to 4252'. Cemented with 250 cu. ft. pozmix. Cleaned out to 4217'. Perforated 8/4207-09. Swabbed 4-5 barrels of saltwater per hour with show of oil and gas. Squeezed perforations with estimated 30 sacks displaced at a maximum of 4000#. Perforated 8/4204-06'. Small show of oil. Perforated 20/4199-4204'. Flowed oil, no water. Perforated 20/4193-4198'. Flowed 18 barrels oil per hour. Perforated 20/4188-93. Flowed 18 1/2 barrels of oil per hour. Well completed 9-6-54.

RECEIVED  
STATE CORPORATION COMMISSION  
APR 22 1970  
CONSERVATION DIVISION  
Wichita, Kansas