


STATE OF KANSAS  
STATE CORPORATION COMMISSION

WELL PLUGGING RECORD

Give All Information Completely  
Make Required Affidavit  
Mail or Deliver Report to  
Conservation Division  
State Corporation Comm.  
245 North Water  
Wichita, KS 67202

Morton County, Sec. 29 Twp. 34S Rge. 43 E/W  
Location as "NE/CNW $\frac{1}{4}$ SW $\frac{1}{4}$ " or footage from lines  
C NE/4 SW/4

Lease Owner Unitized-Anadarko Production Company, Operator  
Lease Name INTERSTATE UNIT Well No. 62  
Office Address P. O. Box 351, Liberal, Kansas 67901  
Character of Well (Completed as Oil, Gas or Dry Hole) Oil

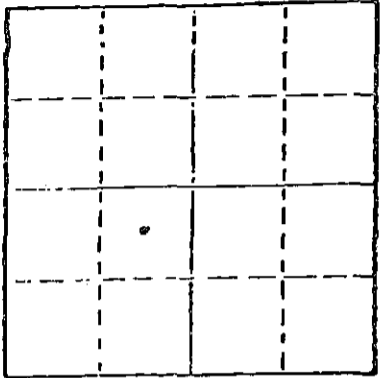

Locate well correctly on above  
Section Plat

Date Well completed September 21 1954  
Application for plugging filed May 22 1979  
Application for plugging approved May 25 1979  
Plugging commenced July 19 1979  
Plugging completed July 20 1979  
Reason for abandonment of well or producing formation  
Casing in bad condition, well uneconomical to produce  
If a producing well is abandoned, date of last production  
March 1971

Was permission obtained from the Conservation Division or  
its agents before plugging was commenced? yes

Name of Conservation Agent who supervised plugging of this well Clarence Thomas  
Producing formation Purdy Morrow Depth to top 4162 Bottom 4216 Total Depth of Well 4250  
Show depth and thickness of all water, oil and gas formations.

OIL, GAS OR WATER RECORDS

CASING RECORD

FORMATION	CONTENT	FROM	TO	SIZE	PUT IN	PULLED OUT
				8-5/8"	1207	None
				5-1/2"	4249	None

Describe in detail the manner in which the well was plugged, indicating where the mud fluid  
was placed and the method or methods used in introducing it into the hold. If cement or other  
plugs were used, state the character of same and depth placed, from \_\_\_\_\_ feet to  
\_\_\_\_\_ feet for each plug set.

Spotted: 70 sxs common cmt @ 1842' (collapsed casing @ 1842' prevented deeper spotting)  
70 sxs common @ 1300'  
15 sxs common 40-0'  
Pumped 40 sxs common down surface pipe

RECEIVED  
STATE CORPORATION COMMISSION

AUG 15 1979 8-15-79

(If additional description is necessary, use BACK of this sheet)


Name of Plugging Contractor Halliburton Services

STATE OF KANSAS COUNTY OF SEWARD, ss.  
Paul Campbell (employee of owner) or ~~XXXXXXXXXXXXXXXXXXXX~~

of the above-described well, being first duly sworn on oath, says: That I have knowledge of  
the facts, statements, and matters herein contained and the log of the above-described well  
as filed and that the same are true and correct. So help me God.

(Signature) Paul Campbell  
P. O. Box 351, Liberal, Kansas 67901  
(Address)

SUBSCRIBED AND SWORN TO before me this 14<sup>th</sup> day of August, 19 79

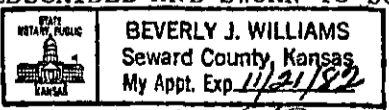

My commission expires November 21, 1982  
Beverly J. Williams  
Notary Public.