


STATE OF KANSAS
STATE CORPORATION COMMISSION

WELL PLUGGING RECORD

Give All Information Completely
Make Required Affidavit
Mail or Deliver Report to
Conservation Division
State Corporation Comm.
245 North Water
Wichita, KS 67202

Morton County, Sec. 29 Twp. 34S Rge. 43 XE/W
Location as "NE/4CNW/4SW/4" or footage from lines
C SW NW

Lease Owner Unitized-Anadarko Production Company-Operator
Lease Name INTERSTATE PURDY UNIT Well No. 56
Office Address P. O. Box 351, Liberal, Kansas 67901
Character of Well (Completed as Oil, Gas or Dry Hole) _____

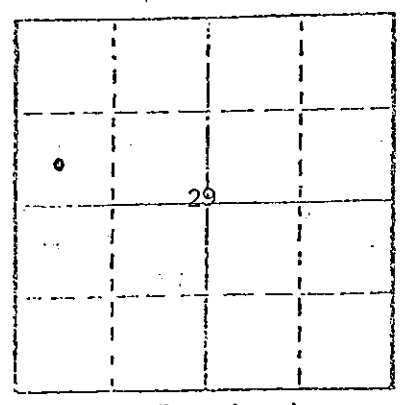

Locate well correctly on above
Section Plot

Oil
Date Well completed February 24 1955
Application for plugging filed September 29 1981
Application for plugging approved December 7 1981
Plugging commenced January 12 1982
Plugging completed January 16 1982

Reason for abandonment of well or producing formation
Casing Leak
If a producing well is abandoned, date of last production
September 23 1978

Was permission obtained from the Conservation Division or
its agents before plugging was commenced? Yes

Name of Conservation Agent who supervised plugging of this well Clarence Thomas
Producing formation Purdy Morrow Depth to top 4156' Bottom 4200' Total Depth of Well 4268'
Show depth and thickness of all water, oil and gas formations.

OIL, GAS OR WATER RECORDS

CASING RECORD

FORMATION	CONTENT	FROM	TO	SIZE	PUT IN	PULLED OUT
				8-5/8"	1174'	None
				5-1/2"	4268'	2416'

Describe in detail the manner in which the well was plugged, indicating where the mud fluid
was placed and the method or methods used in introducing it into the hold. If cement or other
plugs were used, state the character of same and depth placed, from _____ feet to
_____ feet for each plug set.

Spotted 25 sxs cmt from 4110 to 3935'; spotted 25 sxs cmt from 2400 to 2300; spotted 40
sxs cmt from 1100 to 972'; spotted 25 sxs cmt from 500-418'; spotted 10 sxs cmt from
40' to 3' & welded steel cap on 8-5/8".

(If additional description is necessary, use BACK of this sheet)

Name of Plugging Contractor Sargents Casing Pulling Service

STATE OF KANSAS COUNTY OF SEWARD, ss.
Paul Campbell (employee of owner) or ~~(owner or operator)~~

of the above-described well, being first duly sworn on oath, says: That I have knowledge of
the facts, statements, and matters herein contained and the log of the above-described well
as filed and that the same are true and correct. So help me God.

(Signature) Paul Campbell
P. O. Box 351, Liberal, Kansas 67901
(Address)

SUBSCRIBED AND SWORN TO before me this 21st day of January, 1982

STATE NOTARY PUBLIC
BEVERLY J. WILLIAMS
Seward County, Kansas
My Appt. Exp. November 21, 1982

Beverly J. Williams
Notary Public.

My commission expires _____