


WELL PLUGGING RECORD

Give All Information Completely
the Required Affidavit
Mail or Deliver Report to:
Conservation Division
State Corporation Commission
211 No. Broadway
Wichita, Kansas

Morton County. Sec. 28 Twp. 34 Rge. 43 ~~XX~~ (W)
Location as "NE/CNW/SW" or footage from lines G SE NW
Lease Owner Cities Service Oil Company
Lease Name Roll "A" Well No. 2
Office Address Box 1228, Guymon, Oklahoma
Character of Well (completed as Oil, Gas or Dry Hole) Dry hole
Date well completed 4-4 1967
Application for plugging filed 7-13 1967
Application for plugging approved 7-14 1967
Plugging commenced 7-25 1967
Plugging completed 7-26 1967
Reason for abandonment of well or producing formation Dry hole

NORTH

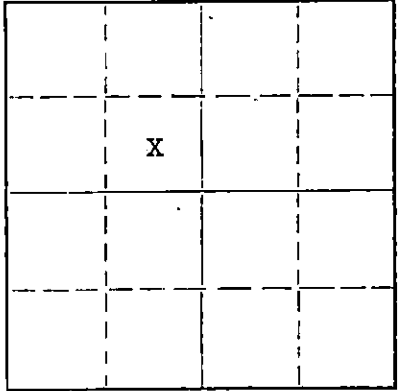

Locate well correctly on above
Section Plat

If a producing well is abandoned, date of last production _____ 19____
Was permission obtained from the Conservation Division or its agents before plugging was commenced? Yes

Name of Conservation Agent who supervised plugging of this well Hugh Scott
Producing formation Red Cave Depth to top 1227 Bottom 1232 Total Depth of Well 1232 Feet
Show depth and thickness of all water, oil and gas formations.

OIL, GAS OR WATER RECORDS CASING RECORD

FORMATION	CONTENT	FROM	TO	SIZE	PUT IN	PULLED OUT
Red Cave	Gas	1227	1232	5 1/2	1202	None

Describe in detail the manner in which the well was plugged, indicating where the mud fluid was placed and the method or methods used in introducing it into the hole. If cement or other plugs were used, state the character of same and depth placed, from _____ feet to _____ feet for each plug set.

Cement plugs as follows: 65 sxs. from 1060' to 1232', 10 sxs. from 65' to 4' below ground level at which point the 5 1/2" casing was cut off and a steel cap welded on top.

RECEIVED
STATE CORPORATION COMMISSION

JUL 27 1967

CONSERVATION DIVISION
Wichita, Kansas

(If additional description is necessary, use BACK of this sheet)

Name of Plugging Contractor Halliburton
Address Duncan, Oklahoma

STATE OF OKLAHOMA, COUNTY OF TEXAS, ss.
I, H. E. Massey (employee of owner) or (owner or operator) of the above-described

well, being first duly sworn on oath, says: That I have knowledge of the facts, statements, and matters herein contained and the log of the above-described well as filed and that the same are true and correct. So help me God.

(Signature) H. E. Massey - Dist. Supt.

Box 1228, Guymon, Oklahoma
(Address)

SUBSCRIBED AND SWORN TO before me this 26th day of July, 1967

My commission expires 10-21-69

Dan B. Codner
Dan B. Codner
Notary Public.

CSE NW

WELL LOG
 Roll "A" #2
 Section 28-34S-43W
 Morton County, Kansas

PROSPECTIVE
 OIL CORPORATION
 AUG 2 1967
 OIL CORPORATION
 OIL CORPORATION

0 - 600	Sand & Clay
600 - 669	Red Bed & Anhydrite
669 - 1205	Anhydrite & Red Bed
1205 - 1212	Red Shale
1212 - 1222	Dolomite
1222 - 1226	Shale
1226 - 1232	TD. Red Cave Formation. 220 MCF/day and 20 barrels of water on 14/64" choke, Casing Pressure 200#, 72 hour SIP 316.1#.

5½" Casing set at 1202' w/350 cu.ft. of salt saturated pozmix w/2% gel and ½# flocele, circulated.