

STATE OF KANSAS  
STATE CORPORATION COMMISSION

WELL PLUGGING RECORD

Give All Information Completely  
Make Required Affidavit  
Mail or Deliver Report to  
Conservation Division  
State Corporation Comm.  
245 North Water  
Wichita, KS 67202

Morton County, Sec. 27 Twp. 34S Rge. 43 E/W  
Location as "NE/CNW1SW1" or footage from lines  
1320' FWL & 1610' FNL

Lease Owner Anadarko Production Company  
Lease Name ROLL "B" Well No. 1

Office Address P. O. Box 351, Liberal, Kansas 67901

Character of Well (Completed as Oil, Gas or Dry Hole)  
GAS


Date Well completed 2/28 1977  
Application for plugging filed 5/13 1980  
Application for plugging approved 5/15 1980  
Plugging commenced 6/26 1980  
Plugging completed 6/26 1980

Reason for abandonment of well or producing formation  
Depleted

If a producing well is abandoned, date of last production  
March 4 1980

Was permission obtained from the Conservation Division or  
its agents before plugging was commenced? yes

Name of Conservation Agent who supervised plugging of this well Mr. Clarence Thomas  
Producing formation Redcave Depth to top 1226 Bottom 1234 Total Depth of Well 1320'  
Show depth and thickness of all water, oil and gas formations.

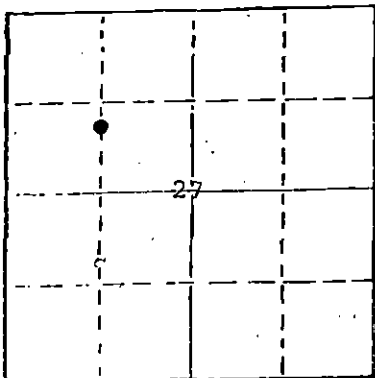

Locate well correctly on above  
Section Plot

OIL, GAS OR WATER RECORDS

CASING RECORD

FORMATION	CONTENT	FROM	TO	SIZE	PUT IN	PULLED OUT
Redcave	Gas & water	1226	1234	8-5/8	366'	none
				4-1/2	1319	none

Describe in detail the manner in which the well was plugged, indicating where the mud fluid was placed and the method or methods used in introducing it into the hold. If cement or other plugs were used, state the character of same and depth placed, from \_\_\_\_\_ feet to \_\_\_\_\_ feet for each plug set.

- PBTD (1313) to 1250 mud thru tubing
- 1250 to 1150 10 sxs cement thru tubing
- 1150 to 410 mud thru tubing
- 410 to 310 10 sxs cement thru tubing
- 310 to 40 mud thru tubing
- 40' to surface cement thru tubing

RECEIVED  
STATE CORPORATION COMMISSION  
AUG 27 1980  
CONSERVATION DIVISION  
Wichita, Kansas

(If additional description is necessary, use BACK of this sheet)  
Name of Plugging Contractor Sargents Casing Pullers

STATE OF KANSAS COUNTY OF SEWARD, ss.

Paul Campbell (employee of owner) or (owner or operator)

of the above-described well, being first duly sworn on oath, says: That I have knowledge of the facts, statements, and matters herein contained and the log of the above-described well as filed and that the same are true and correct. So help me God.

(Signature) Paul Campbell  
P. O. Box 351, Liberal, Kansas 67901  
(Address)

SUBSCRIBED AND SWORN TO before me this 25th day of August, 1980

STATE NOTARY PUBLIC  
BEVERLY J. WILLIAMS  
Seward County, Kansas  
My Appt. Exp. 11/21/82

Beverly J. Williams  
Notary Public.

My commission expires November 21, 1982

15-129-20298-0000

**KANSAS DRILLERS LOG**

S. 27 T. 34S R. 43 E  
 W  
 Loc. 1610' FNL & 1320' FWL  
 County MORTON

API No. 15 — 129 — 20,298  
 County Number

Operator  
**ANADARKO PRODUCTION COMPANY**

Address  
**P. O. BOX 351, LIBERAL, KANSAS 67901**

Well No. 1 Lease Name ROLL "B"

Footage Location  
1610 feet from (N) (S) line 1320 feet from (E) (W) line

Principal Contractor  
**Gabbert-Jones Drlg. Co., Inc.**

Geologist


Spud Date  
**1:30 PM 2/4/77**

Total Depth  
**1320'**

P.B.T.D.

Date Completed  
**2/28/77**

Oil Purchaser

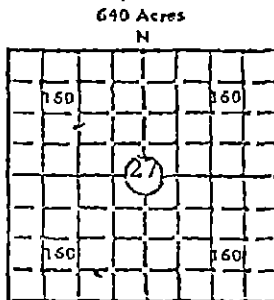

Locate well correctly

Elev.: Cr. 3489.5'

DF \_\_\_\_\_ KB \_\_\_\_\_

**CASING RECORD**

Report of all strings set—surface, intermediate, production, etc.

Purpose of string	Size hole drilled	Size casing set (in O.D.)	Weight lbs/ft.	Setting depth	Type cement	Socks	Type and percent additives
Surface	12-1/4"	8-5/8"	20#	366'	Common	275	3% CaCl
Production	7-7/8"	4-1/2"	10.5#	1319'	Lite Wate. SS Poz	225 150	4% gel 12-1/2% gilsonite

**LINER RECORD**

**PERFORATION RECORD**

Top, ft.	Bottom, ft.	Socks cement	Shots per ft.	Size & type	Depth interval

**TUBING RECORD**

Size	Setting depth	Packer set at
2-3/8"	1242'	

**ACID, FRACTURE, SHOT, CEMENT SQUEEZE RECORD**

Amount and kind of material used	Depth interval treated
A/500 gals 10% MCA w/1/2 gal Hy-Clean. F/5000 gals foamed wtr + 3000# 20-40 sand, used 55,000 Scf Nit.	1226-34'

**INITIAL PRODUCTION**

Date of first production September, 1977 SI for PL CONNECTION	Producing method (flowing, pumping, gas lift, etc.)
RATE OF PRODUCTION PER 24 HOURS	Oil _____ Gas _____ Water _____ 6bls. 618 MCF
Disposition of gas (vented, used on lease or sold)	Producing interval(s) 1226-34'

RECEIVED  
 STATE CORPORATION COMMISSION  
 MAY 15 1977  
 CONSERVATION DIVISION  
 WICHITA, KANSAS

INSTRUCTIONS: As provided in KCC Rule 82-2-125, within 90 days after completion of a well, one completed copy of this Driller's Log shall be transmitted to the State Geological Survey of Kansas, 4150 Monroe Street, Wichita, Kansas 67209. Copies of this form are available from the Conservation Division, State Corporation Commission, 3830 So. Meridian (P.O. Box 17027), Wichita, Kansas 66217. Phone AC 316-522-2206. If confidential custody is desired, please note Rule 82-2-125. Drillers Logs will be on open file in the Oil and Gas Division, State Geological Survey of Kansas, Lawrence, Kansas 66044.

Operator

ANADARKO PRODUCTION COMPANY

DESIGNATE TYPE OF COMP.: OIL, GAS, DRY HOLE, SWDW, ETC.:

GAS

Well No.

1

Lease Name

ROLL "B"

S. 27 T 34S R 43 <sup>K</sup> W

WELL LOG

Show all important zones of porosity and contents thereof; cored intervals, and all drill-stem tests, including depth interval tested, cushion used, time tool open, flowing and shut-in pressures, and recoveries.

SHOW GEOLOGICAL MARKERS, LOGS RUN, OR OTHER DESCRIPTIVE INFORMATION.

FORMATION DESCRIPTION, CONTENTS, ETC.	TOP	BOTTOM	NAME	DEPTH
Sand-Redbed	0'	140'		
Redbed	140'	1320'		
TOTAL DEPTH		1320'		

USE ADDITIONAL SHEETS, IF NECESSARY, TO COMPLETE WELL RECORD.

Date Received

*Paul Campbell*  
Signature

Paul Campbell, Division Production Manager

Title

October 28, 1977

Date