

STATE OF KANSAS
STATE CORPORATION COMMISSION

Form CP-1

Give All Information Completely
Make Required Affidavit
Mail or Deliver Report to:
Conservation Division
State Corporation Commission
212 No. Market
Wichita, Kansas 67202

WELL PLUGGING RECORD

Morton County, Sec. 23 Twp. 34S Rge. 43W (E) (W)

Location as "NE/CNW/SW" or footage from lines NE/4 SW/4
Lease Owner Evans & Trigg - Petrofunds Inc. - Macdonald Oil Corp.

Lease Name Kansas 2-23 Well No. 2=23

Office Address 410 Woolworth Building Boulder, Colorado 80302

Character of Well (completed as Oil, Gas or Dry Hole) Dry Hole

Date well completed September 24, 19 69

Application for plugging filed September 29, (written) 19 69

Application for plugging approved September 30, 19 69


Plugging commenced September 24, 19 69

Plugging completed September 24, 19 69

Reason for abandonment of well or producing formation No commercial oil or gas zones were found by examination or calculation of electric logs.

If a producing well is abandoned, date of last production none 19

Was permission obtained from the Conservation Division or its agents before plugging was commenced? Yes

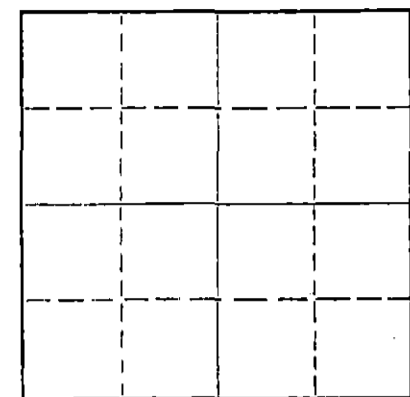

Locate well correctly on above Section Plat

Name of Conservation Agent who supervised plugging of this well E. Eves (Box E Sublette, Kansas)

Producing formation none Depth to top Bottom Total Depth of Well 4900 Feet

Show depth and thickness of all water, oil and gas formations.

OIL, GAS OR WATER RECORDS

CASING RECORD

FORMATION	CONTENT	FROM	TO	SIZE	PUT IN	PULLED OUT
Dakota XXXX	Water			8 5/8"	1179'	none

Describe in detail the manner in which the well was plugged, indicating where the mud fluid was placed and the method or methods used in introducing it into the hole. If cement or other plugs were used, state the character of same and depth placed, from feet to feet for each plug set.

Filled Hole with heavy mud.

50 Sack cement plug placed in the bottom of surface pipe.

RECEIVED
CORPORATION COMMISSION
OCT 24 1969
CONSERVATION DIVISION
Wichita, Kansas

Name of Plugging Contractor Service Drig. Company
Address 406 So. Boulder, Tulsa, Oklahoma

STATE OF Colorado, COUNTY OF Boulder, ss.
Jack E. Trigg, agent (employee of owner) or (owner or operator) of the above-described

well, being first duly sworn on oath, says: That I have knowledge of the facts, statements, and matters herein contained and the log of the above-described well as filed and that the same are true and correct. So help me God.

(Signature) Jack E. Trigg agent
410 Woolworth Building Boulder, Colorado


SUBSCRIBED AND SWORN TO before me this 22nd day of October, 19 69

My commission expires August 6, 1973

Reginald A. Campbell
Notary Public.

DISPOSAL

Will give adequate
that fresh-water
tion near its
to be en-
need dis-

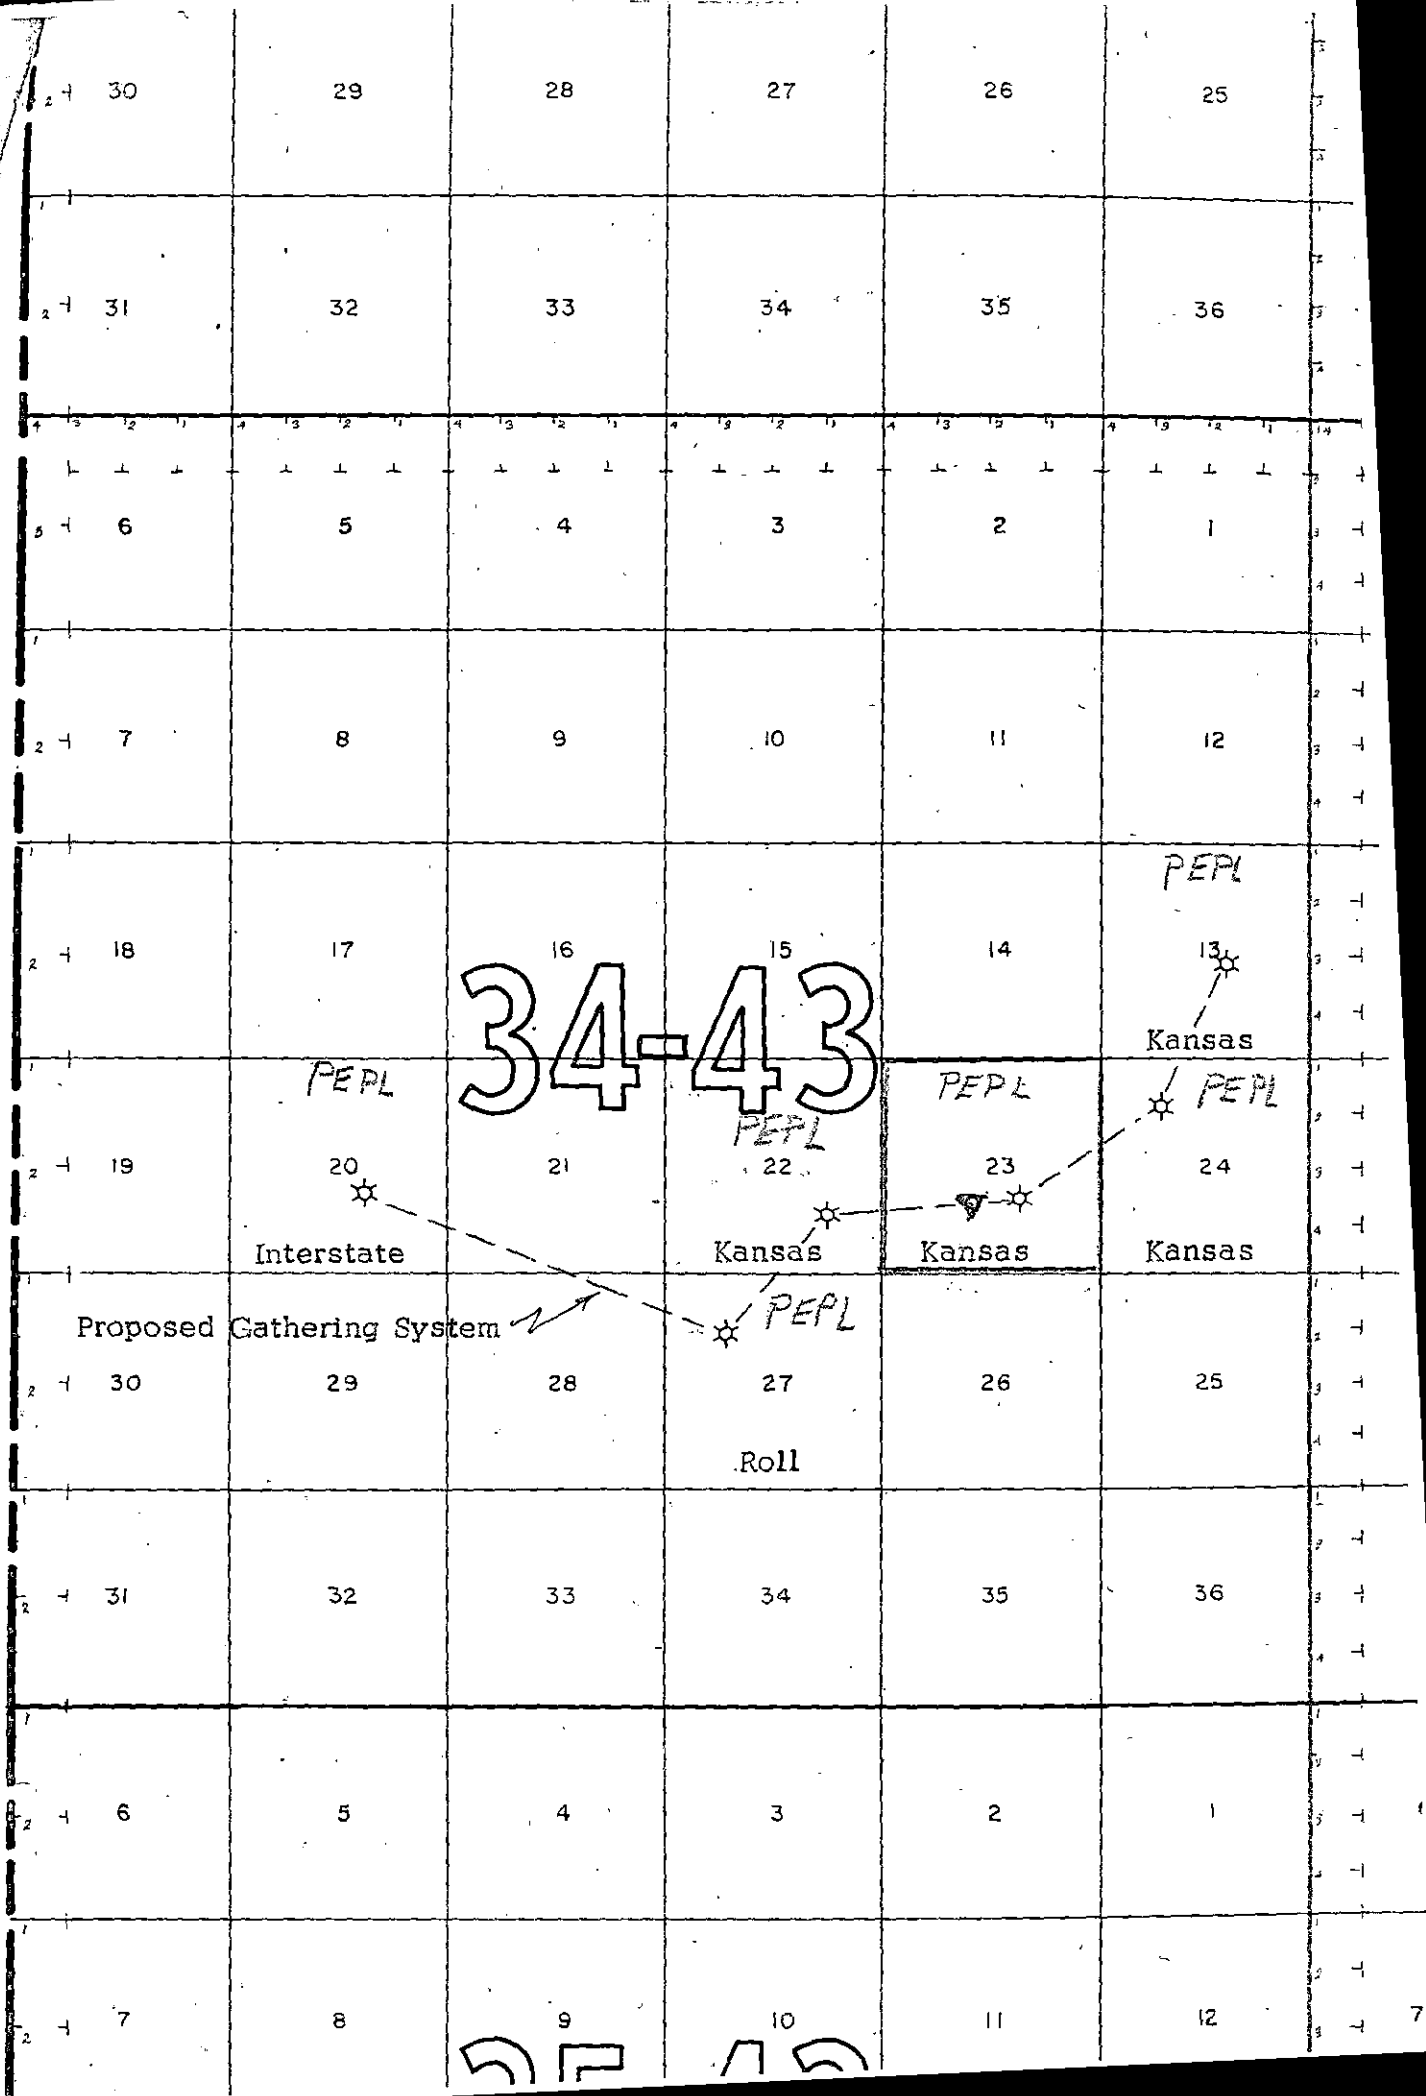

34-43