


STATE OF KANSAS
STATE CORPORATION COMMISSION
Give All Information Completely
Make Required Affidavit
Mail or Deliver Report to:
Conservation Division
State Corporation Commission
800 Bittig Building
Wichita, Kansas

WELL PLUGGING RECORD

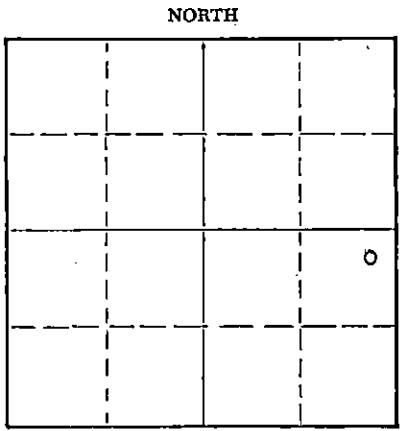

Locate well correctly on above Section Plat

Sumner County. Sec. 18 Twp. 35S Rge. 2 (W)
 Location as "NE/CNW/SW" or footage from lines NE NE SE
 Lease Owner Herndon Drilling Company
 Lease Name J. Patton #1 Well No. _____
 Office Address Drawer 489 - Tulsa, Oklahoma
 Character of Well (completed as Oil, Gas or Dry Hole) Dry Hole
 Date well completed 7/7 1955
 Application for plugging filed 7/7 1955
 Application for plugging approved 7/7 1955
 Plugging commenced 7/7 1955
 Plugging completed 7/7 1955
 Reason for abandonment of well or producing formation _____

If a producing well is abandoned, date of last production _____ 19____
 Was permission obtained from the Conservation Division or its agents before plugging was commenced? W. G. Buffington, R.R. #2, Geuda Springs, Kansas

Name of Conservation Agent who supervised plugging of this well _____
 Producing formation _____ Depth to top _____ Bottom _____ Total Depth of Well 4849 Feet
 Show depth and thickness of all water, oil and gas formations.

OIL, GAS OR WATER RECORDS

CASING RECORD

FORMATION	CONTENT	FROM	TO	SIZE	PUT IN	PULLED OUT

Describe in detail the manner in which the well was plugged, indicating where the mud fluid was placed and the method or methods used in introducing it into the hole. If cement or other plugs were used, state the character of same and depth placed, from 240 feet to 40 feet for each plug set.

Hole was filled w/ Rotary Mud to 240 feet. Plug set and 15 sxs. cement mixed and poured through drill pipe. Hole was filled to 40 ft. plug set and 10 sx. was mixed and poured through drill pipe. Cap was welded on surface.

(If additional description is necessary, use BACK of this sheet)

Name of Plugging Contractor Herndon Drilling Co.
 Address _____

STATE OF Oklahoma, COUNTY OF Tulsa, ss.
Tom Elliott (employee of owner) or (owner/operator) of the above-described well, being first duly sworn on oath, says: That I have knowledge of the facts, statements, and matters herein contained and the log of the above-described well as filed and that the same are true and correct. So help me God.

(Signature) Tom Elliott
121 No. Mission - Council Grove, Kansas
 (Address)

SUBSCRIBED AND SWORN TO before me this 11th day of July, 19 55

My commission expires 4/22/57

Ray M. Neering
 Notary Public.

PLUGGING
 FILE SEC 18 T 35S R 2W
 BOOK PAGE 132 LINE 36

RECEIVED
 STATE OF KANSAS

7-15-55
 CONSERVATION DIVISION
 WICHITA, KANSAS

WELL LOG ON PATTON #1

Spudding date: 6/10/55
Date casing set: 6/11/55
Date rotary completed: 7/7/55
Date cable completed:

Location:
Sec. 18-35S-2W - Sumner Co., Kansas

FROM	TO	FORMATION	REMARKS
0	260	Surface Hole	Ran 8 Jts. 8-5/8" 24# Casing to 262'
260	640	Shale & Shells	Cemented w/ 250 Sx. Pozmix w/ 300# CC
640	2585	Lime & Shale	
2585	2680	Lime	
2680	3135	Lime & Shale	
3135	3365	Shale & Sand	
3365	3445	Lime & Shale	
3445	3585	Shale	
3585	3628	Shale & Sand	
3628	3650	Shale & Lime	
3650	3745	Shale & Sand	
3745	4385	Lime & Shale	
4385	4405	Lime	
4405	4430	Shale & Shells	
4430	4463	Shale & Lime	
4463	4721	Lime	
4721	4758	Shale & Lime	
4758	4810	Lime	
4810	4848	Shale & Lime	
4848	4849	Lime	
4849		Total Depth	

Plugged w/ 15 Sx. Cement @ 240' and
10 Sx. Cement on Top Plug

Subscribed and sworn to before me this 14th
day of July, 1955

I certify the above and foregoing to be a true and exact
copy of the original driller's log on the PATTON #1

STATE COMMISSION

JUL 13 1955

HERNDON DRILLING COMPANY

Patsy M. Mearns
Notary Public

P. J. Moore
By:

My commission expires: 4/22/57

Title: Assistant Secretary

PLUGGING
FLX SEC 18 T 35 R 2W
BOOK PAGE 132 LINE 26