

STATE OF KANSAS  
STATE CORPORATION COMMISSION

Form CP-4


Give All Information Completely  
Make Required Affidavit  
Mail or Deliver Report to:  
Conservation Division  
State Corporation Commission  
211 No. Broadway  
Wichita, Kansas

WELL PLUGGING RECORD

Stevens County, Sec. 14 Twp. 34S. Rge. 37W. (E) (W)

Location as "NE/CNW/SW" or footage from lines C. N.E. S.E.  
Lease Owner Bovaird Supply Company  
Lease Name Loether Well No. 1  
Office Address 525 S. Western Liberal, Kansas 67901  
Character of Well (completed as Oil, Gas or Dry Hole) Dry Hole  
Date well completed 9-8 19 71  
Application for plugging filed 4-9 19 73  
Application for plugging approved 4-10 19 73  
Plugging commenced 4-10 19 73  
Plugging completed 4-12 19 73  
Reason for abandonment of well or producing formation nonproducing

NORTH

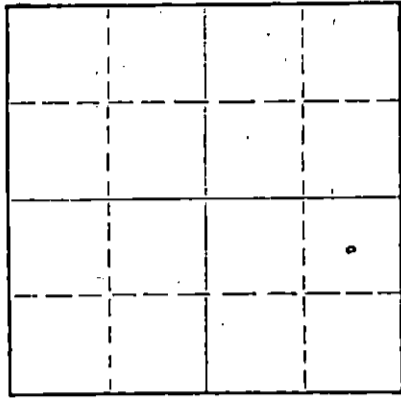

Locate well correctly on above Section Plat

If a producing well is abandoned, date of last production \_\_\_\_\_ 19 \_\_\_\_  
Was permission obtained from the Conservation Division or its agents before plugging was commenced? Yes

Name of Conservation Agent who supervised plugging of this well Ed Eves  
Producing formation Lower Morrow Depth to top 6362 Bottom 6381 Total Depth of Well 6815 Feet  
Show depth and thickness of all water, oil and gas formations.

OIL, GAS OR WATER RECORDS

CASING RECORD

FORMATION	CONTENT	FROM	TO	SIZE	PUT IN	PULLED OUT
				8 5/8	1777	none
				4 1/2	6815	2818

Describe in detail the manner in which the well was plugged, indicating where the mud fluid was placed and the method or methods used in introducing it into the hole. If cement or other plugs were used, state the character of same and depth placed, from \_\_\_\_\_ feet to \_\_\_\_\_ feet for each plug set.

- 20 sks. @ 6100
- 35 sks. @ 900 to 800
- 15 sks. @ 45 to 0

Pumped 20 sks. of cement at 6100 to 6320 and displaced with mud.  
Mud to 900 ft. and pump 35 sks. cement at 900 to 800 ft.  
Mud to 45 ft. and put 15 sks. at 45 to 0 ft.

RECEIVED  
STATE CORPORATION COMMISSION  
APR 26 1973  
CONSERVATION DIVISION  
Wichita, Kansas

(If additional description is necessary, use BACK of this sheet)  
Name of Plugging Contractor Sargent's Casing Pulling Service Kansas No. 511  
Address P.O. Box 506 Liberal, Kansas 67901

STATE OF Kansas, COUNTY OF Seward, ss.

\_\_\_\_\_, (employee of owner) or (owner or operator) of the above-described well, being first duly sworn on oath, says: That I have knowledge of the facts, statements, and matters herein contained and the log of the above-described well as filed and that the same are true and correct. So help me God.

(Signature) Harland L. Thompson  
Box 358 Liberal, Kansas  
(Address)

SUBSCRIBED AND SWORN TO before me this 25th day of April 1973

Marianne Smith  
Notary Public.

My commission expires 3/1/73  
**MARIANNE SMITH**  
NOTARY PUBLIC  
Seward County, Ks.  
My Commission Expires  
Dec. 2, 1973

# WELL LOG

COMPANY BLAIK OIL COMPANY

SEC. 14 T. 34S R. 37W

FARM LOETHER NO. 1


LOC. C-NE-SE

TOTAL DEPTH 6815'

COUNTY Stevens Co., Ks.

COMM. July 26, 1971 COMP. August 9, 1971

CONTRACTOR Zenith Drilling Corporation, Inc.  
Wichita, Kansas

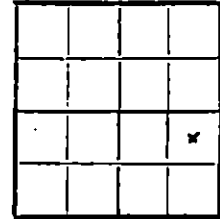

CASING

8 5/8" @1777' w/ 700 sx.

ELEVATION

PRODUCTION D & A

FIGURES INDICATE BOTTOM OF FORMATIONS

1325'	Red Bed, Gyp., Sand
1784'	Sand, Shale, Anhydrite
2494'	Shale, Anhydrite
2670'	Shale, Shells
2925'	Shale, Lime
4207'	Lime
4350'	Lime, Shale
4575'	Lime
4775'	Lime, Shale, Chert
5055'	Lime
5604'	Lime, Shale
6100'	Shale, Lime
6381'	Shale
6815' T.D.	Lime

RECEIVED  
STATE CORPORATION COMMISSION  
SEP 7 1971  
CONSERVATION DIVISION  
Wichita, Kansas

State of Kansas }  
County of Sedgwick } 89

I, C. Robert Buford, President of Zenith Drilling Corporation, Inc.

upon oath state the above and foregoing is a true and correct copy of the log of the Loether #1 well.

C. Robert Buford

Subscribed and sworn to before me this 27th day of August, 1971.

My Commission Expires: August 15, 1975.

Myrna S. Murphy  
NOTARY PUBLIC