


STATE OF KANSAS
STATE CORPORATION COMMISSION

Form CP-4

Give All Information Completely
Make Required Affidavit
Mail or Deliver Report to:
Conservation Division
State Corporation Commission
212 N. Market
Wichita, Kansas

WELL PLUGGING RECORD

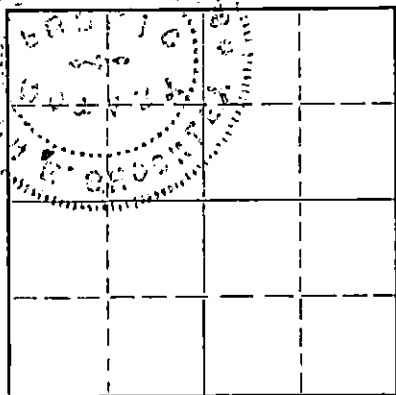

Locate well correctly on above
Section Plat

Morton County, Sec. 20 Twp. 33S Rge. 40 (E) W (W)
Location as "NE/CNW/SW" or footage from lines 660' FWL & 1980' FNL
Lease Owner Anadarko Production Company
Lease Name Davison "A" Well No. 1
Office Address Box 351 Liberal, Kansas 67901
Character of Well (completed as Oil, Gas or Dry Hole) Dry Hole
Date well completed 1969
Application for plugging filed Verbal Approval 6-23 1969
Application for plugging approved 6-23 1969
Plugging commenced 6-23 1969
Plugging completed 6-23 1969
Reason for abandonment of well or producing formation Dry

If a producing well is abandoned, date of last production 1969
Was permission obtained from the Conservation Division or its agents before plugging was commenced? Yes

Name of Conservation Agent who supervised plugging of this well Edgar J. Eves, Sublette, Kansas
Producing formation Depth to top Bottom Total Depth of Well 5860 Feet
Show depth and thickness of all water, oil and gas formations.

OIL, GAS OR WATER RECORDS

CASING RECORD

FORMATION	CONTENT	FROM	TO	SIZE	PUT IN	PULLED OUT
				8 5/8"	1518'	None

Describe in detail the manner in which the well was plugged, indicating where the mud fluid was placed and the method or methods used in introducing it into the hole. If cement or other plugs were used, state the character of same and depth placed, from feet to feet for each plug set.

Spotted 25 sacks cement @ 5500'
Spotted 35 Sacks cement from 900' - 900'
Spotted 15 sacks cement from 45' - 0'
Completed 6:00 P.M. 6-23-69

RECEIVED
STATE CORPORATION COMMISSION
JUN 30 1969
CONSERVATION DIVISION
Wichita, Kansas

(If additional description is necessary, use BACK of this sheet)

Name of Plugging Contractor Lohmann-Johnson Drilling Co., Inc.
Address 413-100 Park Avenue Building, Oklahoma City, Oklahoma

STATE OF Kansas, COUNTY OF Seward, ss.
V. K. Downey (employee of owner) or (owner or operator) of the above-described well being first duly sworn on oath, says: That I have knowledge of the facts, statements, and matters herein contained and the log of the above-described well as filed and that the same are true and correct. So help me God.

(Signature)

Box 351 Liberal, Kansas 67901
(Address)

SUBSCRIBED AND SWORN TO before me this 26th day of June, 1969

John E. Shockley

Notary Public.

My Commission expires April 21, 1973

15-129-20041-0000

DRILLER'S LOG

WELL NAME: Davison "A" No. 1; COMPANY OPERATING: Anadarko Production Company
 ADDRESS of COMPANY: Box 351 Liberal, Kansas 67901
 WELL LOCATION: $\frac{1}{4}$ SW $\frac{1}{4}$ NW $\frac{1}{4}$,
3310 ft. North of South line,
660 ft. East of West line: Sec. 20, Twp. 33S, Rge. 40W, Morton County, Kansas
 DRILLING STARTED 6-7, 1969; DRILLING COMPLETED 6-20, 1969
 WELL COMPLETED 6-23, 1969; WELL CONNECTED _____, 19____
 ELEVATION: 3297.7 ft. Ground Level; CHARACTER OF WELL (Oil, Gas, or Dry Hole) Dry Hole

OIL OR GAS SANDS OR ZONES - PERFORATIONS - ACIDIZING AND FRACTURING INFORMATION

Name	From	To	No. of Shots	Gallons Used	Kind Used

CASING RECORD

Size	Amount Set	Sacks of Cement	Amount Pulled
<u>8 5/8"</u>	<u>1519'</u>	<u>800</u>	<u>None</u>

FORMATION RECORD

Formation	Top	Bottom	Formation	Top	Bottom
Sand	0'	375'			
Shale & Shells	375'	1519'			
Snhydrite	1519'	1525'			
Shale	1525'	1540'			
Shale & Anhydrite	1540'	2511'			
Lime	2511'	4360'			
Lime & Shale	4360'	5300'			
Shale, -Lime & Sand	5300'	5491'			
Shale & Lime	5491'	5560'			
Lime	5560'	5860'			
Total Depth	5860'				

RECEIVED
 STATE CORPORATION COMMISSION
 JUN 30 1969
 CONSERVATION DIVISION
 Wichita, Kansas

RESULTS of INITIAL PRODUCTION TEST: P & A 6-23-69