


STATE OF KANSAS
STATE CORPORATION COMMISSION

WELL PLUGGING RECORD

Give All Information Completely
Make Required Affidavit
Mail or Deliver Report to
Conservation Division
State Corporation Comm.
245 North Water
Wichita, KS 67202

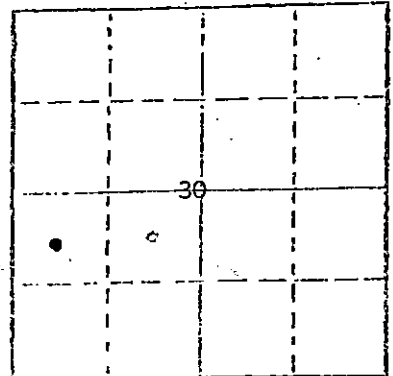

Locate well correctly on above
Section Plat

Morton County, Sec. 30 Twp. 33S Rge. 40 E/W
Location as "NE/CNW1SW1" or footage from lines
C NW SW
Lease Owner Anadarko Production Company
Lease Name CHEROKEE "E" Well No. 1
Office Address P. O. Box 351, Liberal, Kansas 67901
Character of Well (Completed as Oil, Gas or Dry Hole)
DRY HOLE
Date Well completed October 22 19 81
Application for plugging filed January 11 19 82
Application for plugging approved verbal October 21 19 81
Plugging commenced October 22 19 81
Plugging completed October 22 19 81
Reason for abandonment of well or producing formation
DRY HOLE

If a producing well is abandoned, date of last production
19

Was permission obtained from the Conservation Division or
its agents before plugging was commenced? YES

Name of Conservation Agent who supervised plugging of this well Mr. Clarence Thomas
Producing formation Depth to top Bottom Total Depth of Well 5875'
Show depth and thickness of all water, oil and gas formations.

OIL, GAS OR WATER RECORDS

CASING RECORD

FORMATION	CONTENT	FROM	TO	SIZE	PUT IN	PULLED OUT
				8-5/8"	1529'	-0-

Describe in detail the manner in which the well was plugged, indicating where the mud fluid
was placed and the method or methods used in introducing it into the hold. If cement or other
plugs were used, state the character of same and depth placed, from feet to
feet for each plug set.

Spotted 50 sxs cmt @ 2700, 40 sxs @ 1550 w/rubber plug, 10 sxs 40-0, 5 sxs rathole,
had heavy drilling mud between plugs, complete at 7 am 10/22/81.

(If additional description is necessary, use BACK of this sheet)

Name of Plugging Contractor Gabbert-Jones, Inc.

STATE OF KANSAS COUNTY OF SEWARD, ss.
Paul Campbell (employee of owner) or ~~XXXXXXXXXXXXXXXXXXXX~~
of the above-described well, being first duly sworn on oath, says: That I have knowledge of
the facts, statements, and matters herein contained and the log of the above-described well
as filed and that the same are true and correct. So help me God.

(Signature) *Paul Campbell*
P. O. Box 351, Liberal, Kansas 67901
(Address)

SUBSCRIBED AND SWORN TO before me this 25th day of January, 1982

My commission expires November 21, 1982
BEVERLY J. WILLIAMS
Seward County, Kansas
Notary Public

RECEIVED
STATE CORPORATION COMMISSION

JAN 28 1982

CONSERVATION DIVISION
Wichita, Kansas